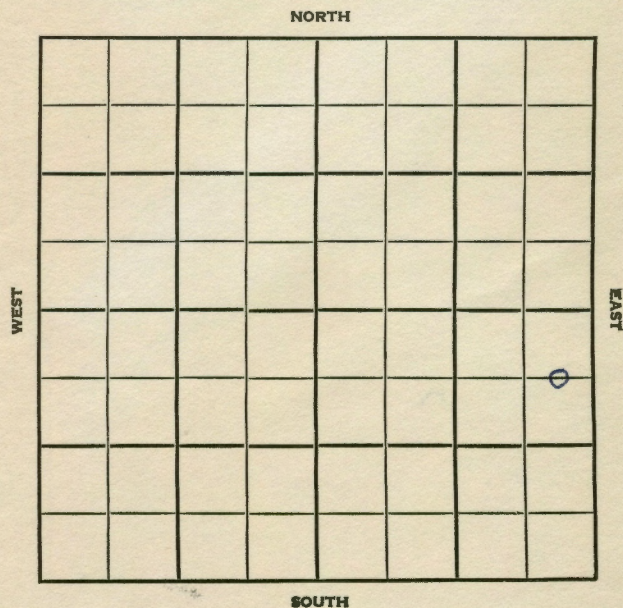


Section 1 Township 35 Range 2 EWell No. #1 BartonCompany Bachus Oil

SEC. <u>1</u>	TWP. <u>35</u>	R. <u>## 2E</u>
---------------	----------------	-----------------

WELL NO.

#1 Barton

FARM


COMPANY

Bachus Oil

CONTRACTOR

Martin

Murphy

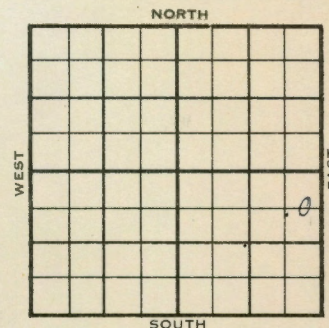700 Ft. from N. Line Ft. from S. Line200 Ft. from E. Line Ft. from W. LineC E $\frac{1}{2}$ NE SE

1956

ELEVATION

1202

REPORT

2-8

Comm. 2-3-56
Drlg.

3-14

DST 3120-38 op 1 hr. rec. 60' gas, 30' gcm, 70/20"

DST 3494-3505 op 1 $\frac{1}{2}$ hr. rec. 10' ocm
30' o&wcm, 60' wcm, 30' wtr., 770/30"
5 $\frac{1}{2}$ " @ 3539/50CO. to 3526, 24/ 3509-12, rec. mud,
CO to 3526, 4/ 3522-23

Comp. 25 bopd

Layton 2784

KC 2988

Cleve 3126

Osw. 3193

Bart 3495

TD 3540

COMPLETED

County Sumner Elev. 1202
 Sec. 1 Twp. 35 Rge. 2E
 Company Bachus Oil
 Farm Name Barton No. 4

TOPS	DEPTH	LOG	DATUM	Loc. in Sec.
Anh.				C E $\frac{1}{2}$ NE SE
TP.				
H. <u>Layton</u>	<u>2784</u>		<u>1582</u>	700' NL
Tr.				200' EL
Dg.				
BL.				
L.				Geol.
K.C.	<u>2988</u>		<u>1780</u>	
B.K.C.	<u>3126</u>		<u>1924</u>	Contr.
Ce. <u>Clear</u>	<u>3193</u>		<u>1991</u>	<u>Martin</u>
C. <u>Bart</u>	<u>3495</u>		<u>2338</u>	
M.				Pool
M.				<u>Murphy</u>
K.				
Mz.				
Me.				
V.				
S.				
S.				
A.				
R.				
PE.				
G.				
TD.	<u>3540</u>			

Date Comm. 2-3-55

MAR 14 1956

DST 3120-38 open 1 hr. rec. 60' gas
 30' gcm 70/20" DST 3494-3505
 open 1 $\frac{1}{2}$ hr. rec. 10' ocm 30' o & wcm
 60' wcm 30' wtr. 770/30" 5 $\frac{1}{2}$ " @ 3539/50
 CO to 3526 24/ 3509-12 rec. mud
 CO to 3526 14/ 3522-23 Comp. 25 bopd

County Sumner Elev. 1202
 Sec. 1 Twp. 35 Rge. 2E
 Company Bachus Oil
 Farm Name Barton No. 4

TOPS	DEPTH	LOG	DATUM	Loc. in Sec.
Anh.				C E $\frac{1}{2}$ NE SE
TP.				
H.				700' NL
Tr.				200' EL
Dg.				
BL.				
L.				Geol.
K.C.				
B.K.C.				Contr.
Ce.				<u>Martin</u>
C.				
M.				Pool
K.				<u>Murphy</u>
Mz.				
Me.				
V.				
S.				
S.				
A.				
R.				
PE.				
G.				
TD.				

Date Comm. 2-3-55

drlg.

FIRST REPORT

FEB 8 '56