


SECTION 1 TOWNSHIP 35 RANGE 2 E

WELL NO. #8 McLaughlin "B"

COMPANY Smitherman

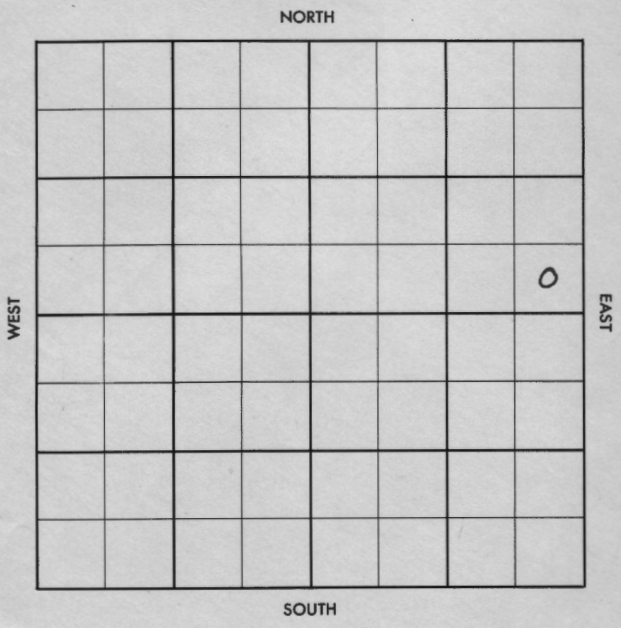


SEC. 1 TWP. 35 R. 2E

WELL NO. #8 McLaughlin "B" FARM

COMPANY Smitherman

CONTRACTOR Co. tools

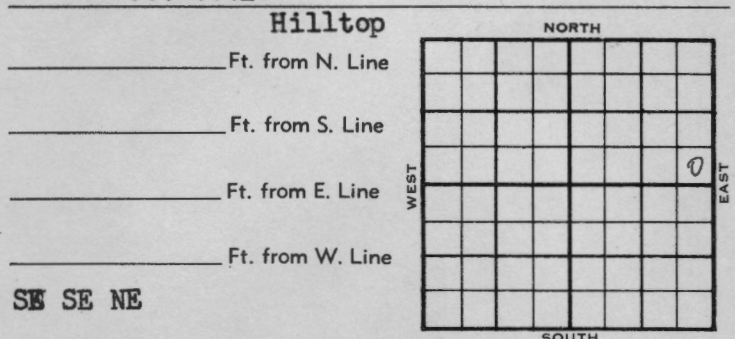

1956 ELEVATION REPORT

1-5 Cellar & pits

DX-78

County Summer Elev. 1209  
 Sec. 1 Twp. 35 Rge. 2E  
 Company Snitherman  
 Farm Name McLaughlin "B" No. 8

TOPS	DEPTH	LOG	DATUM	Loc. in Sec.
Anh.				
Tp. <u>Lay</u>		<u>2792</u>	<u>1543</u>	<u>SE SE NE</u>
H. <u>OSD</u>		<u>3128</u>	<u>1989</u>	
Tr. <u>Barth</u>		<u>2487</u>	<u>2278</u>	<u>430 24</u>
Dp.				
Bl.				
L.				
K.C.				Geol.
B.K.C.				Contr.
Co.				Co. tools
C.				
M.				Pool
K.				Hilltop
Me.				
V.				
S.				
S.				
A.				
R.				
PE.				
G.				
TD.				
	<u>3540</u>			

COMPLETE

FEB 15 1956

Date Comm. Cellar & pits JAN 11 '56 1-4-56 8 1/2  
125 / Ø 2206 JAN 18 '56 5 1/2  
3540 / JAN 25 '56 WOCT FEB 1 '56 / FEB 8 '56  
 FEB 18 '56 ca 3519 24/3496-3502  
24/3507-13 est Flw 10 TA 12  
Boph  
Flw 25 Boph rd/wtr

County Summer Elev. 1209  
 Sec. 1 Twp. 35 Rge. 2E  
 Company Snitherman  
 Farm Name McLaughlin No. 8

TOPS	DEPTH	LOG	DATUM	Loc. in Sec.
Anh.				
Tp.				<u>SE SE NE</u>
H.				
Tr.				
Dp.				
Bl.				
L.				
K.C.				Geol.
B.K.C.				Contr.
Co.				Co. tools
C.				
M.				Pool
K.				Hilltop
Me.				
V.				
S.				
S.				
A.				
R.				
PE.				
G.				
TD.				

FIRST REPORT  
 JAN 5 '56

Date Comm.

Cellar & pits