


KANSAS
SECTION 1 TOWNSHIP 35 RANGE 2E
WELL NO. #2 McLaughlin "C"
COMPANY L.C. Smitherman

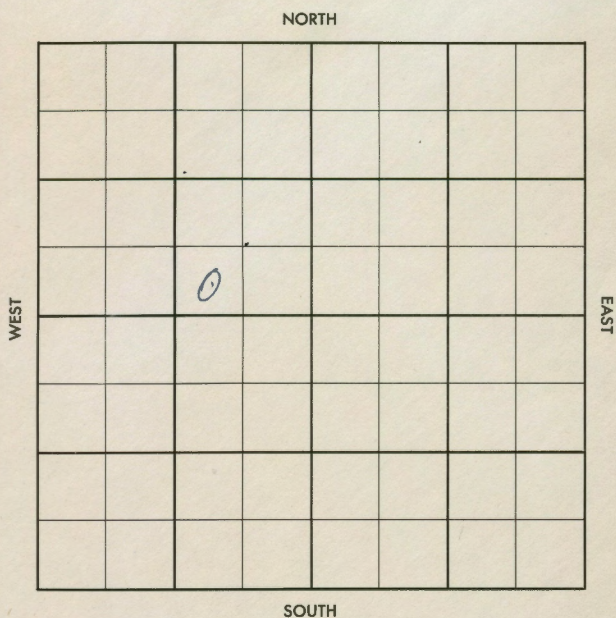


FORM 504-3 SUNRAY

KANSAS
SEC. 1 TWP. 35 R. 2E
WELL NO. #2 McLaughlin "C" FARM
COMPANY L. C. Smitherman

CONTRACTOR
Se-Ro-Bee
Murphy

_____ FT. FROM N. LINE
_____ FT. FROM S. LINE
_____ FT. FROM E. LINE
_____ FT. FROM W. LINE

SW SE NW

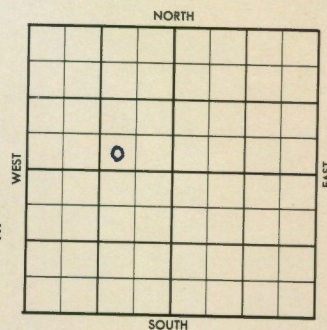

ELEVATION		REPORT
1956		
9-12	Comm 9-8-56 8" @ 180 Drlg 1299	

FORM 504-5 SUNRAY

CORRECTION

FORM 513 SUNRAY

County Sumner Elev. 1204 DF
 Sec. 1 Twp. 35 Rge. 2E
 Company L. C. Smitherman
 FarmName McLaughlin "C" No. 22

TOPS	DEPTH	LOG	DATUM	Loc. in Sec.
Anh.				
Tp. <u>Stall</u>		<u>2394</u>		<u>SW SE NW</u>
H. <u>lay</u>		<u>2806</u>		
Tr.				
Dg.				
Bl.				
L.				
K.C.		<u>3001</u>		Geol.
B.K.C.		<u>3208</u>		Contr.
Ce. <u>Barth.</u>		<u>2492</u>		<u>Se-Ro-Bee</u>
C.				
M.				
N.				
K.				
Mz.				Pool
Ma.				<u>Murphy</u>
V.				
S.				
A.				
R.				
Pe.				
G.				
T.D.	<u>3532</u>			

Date Comm. 9-8-56
8" @ 180 drlg. 1299 SEP 19 56 17 3310
SEP 26 56 5 1/2 @ 3532/100 603530
36/3518-26 P 25 Bopd
To Frac OCT 3 56 OCT 10 56 OCT 17 56
P. 65 Bopd + 10 Bwpd.

FORM 513 SUNRAY

County Sumner Elev. 1204 DF
 Sec. 1 Twp. 35 Rge. 2E
 Company L. C. Smitherman
 FarmName McLaughlin No. 1

TOPS	DEPTH	LOG	DATUM	Loc. in Sec.
Anh.				
Tp.				<u>SW SE NW</u>
H.				
Tr.				
Dg.				
Bl.				
L.				
K.C.				Geol.
B.K.C.				Contr.
Ce.				<u>Se-Ro-Bee</u>
C.				
M.				
N.				
K.				Pool
Mz.				<u>Murphy</u>
Ma.				
V.				
S.				
A.				
R.				
Pe.				
G.				
T.D.				

Date Comm. 9-8-56
8" @ 180 drlg. 1299

SEP 26 56 5 1/2 @ 3532/100 603530
36/3518-26 P 25 Bopd
To Frac OCT 3 56 OCT 10 56 OCT 17 56
P. 65 Bopd + 10 Bwpd.