



Section 2 Township 35 Range 2E
Well No. #1 McIrwin "C" (McIrvin)
Company Aladdin Pet.

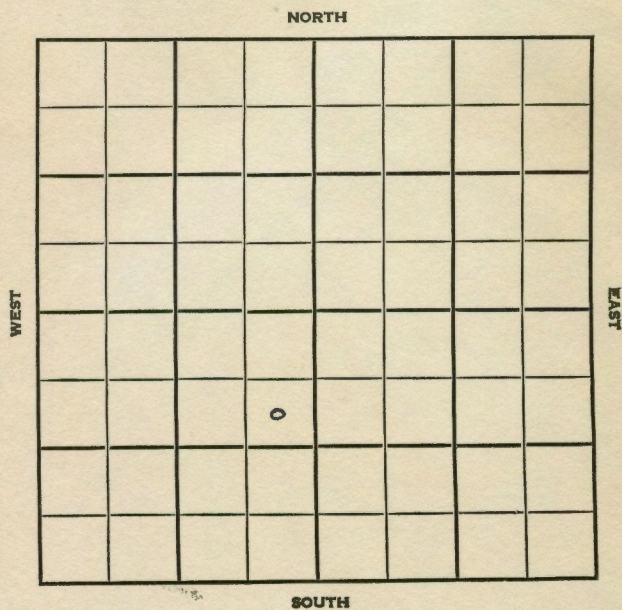

Summer **KANSAS**
SEC. 2 TWP. 35 R. 2E
WELL NO. 1 McIrwin "C" FARM
COMPANY Aladdin Petr.
CONTRACTOR

Crowe Drlg.
Padget Pool

990 Ft. from N. Line
Ft. from S. Line
330 Ft. from E. Line
Ft. from W. Line

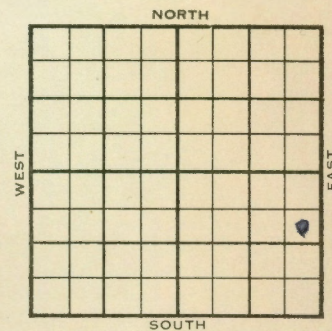

SE NE SW

1955

ELEVATION

REPORT

4/13

Location

