


DX 78-1 **O.W.W.O.**

Section 1 Township 35 Range 2E
Well No. #1 McLaughlin "C"
Company Smitherman

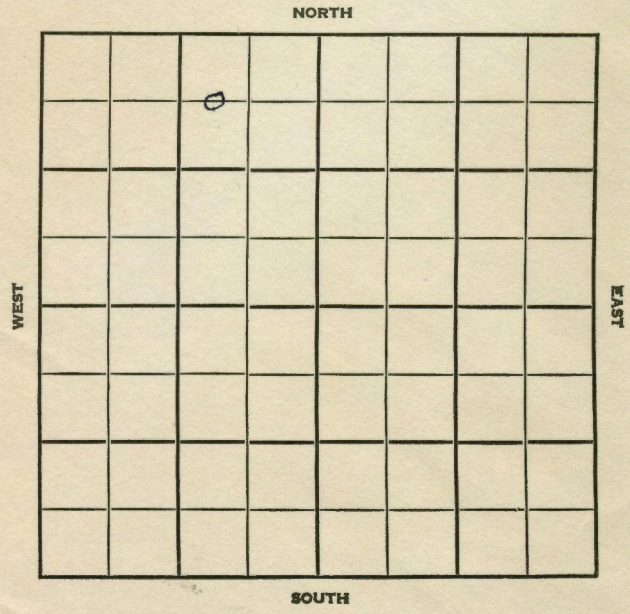

O.W.W.O. **Sumner KANSAS**

SEC. <u>1</u>	TWP. <u>35</u>	R. <u>2E</u>
---------------	----------------	--------------

WELL NO. 1 McLaughlin "C" FARM

COMPANY Smitherman

CONTRACTOR

Hilltop Pool

660 Ft. from N. Line

_____ Ft. from S. Line

990 Ft. from E. Line

_____ Ft. from W. Line

C W/2 NE NW

1955	ELEVATION 1211'	REPORT
------	------------------------	--------

4/13 **Surface Set**

4/27 Spud 4-15-55 D & A TD 3588
8" @ 100 Stal. 2404 Layton 2817
Bart 3478
DST 3478-3519 open 1 hr rec 34' GCM
80# Miss 3538
DST 339-88 open 1 hr rec 60' SW
30' GCM 670# TD 3588
D & A

1955 **ABANDONED**
10/26 **O.W.W.O.**
CO 5" @ 3566 Perf Bart
Test 27 BOPD 200 BW T & R
Stal. 2404', Layton 2817', Bart 3478
Miss 3538' TD 3588'

OVER

1955

11/9

OTD 3588

~~22 55~~ CO

5" @ 3566

Stal 2404

Layton 2817

Bart 3478

M 3538

TD 3588

27 bopd 2 00 bw 24/3509-14 frac

Comp 25 bopd 175 bw

COMPLETED

O.W.W.O.

County Sumner Elev. 1211
 Sec. 1 Twp. 35 Rge. 2E
 Company L. C. Smitherman
 FarmName McLaughlin "C" No. 1

Co.

Loc.

No.

Sec.

T.

R.

TOPS	DEPTH	LOG	DATUM	Loc. in Sec.
Anh.				W ¹ / ₄ NE NW
Tr.				
H.	<u>Stal.</u>		<u>1193</u>	
Tr.	<u>Layton</u>		<u>1606</u>	
Dg.	<u>Bart.</u>		<u>2267</u>	
Bl.				
L.				
K.C.				Geol.
B.K.C.				Contr.
Ce.				
C.				
M.	<u>3538</u>		<u>2327</u>	
M.				Pool
K.				<u>Hilltop</u>
Mz.				
Me.				
V.				
S.				
S.				
A.				
R.				
Pe.				
G.				
T.D.	<u>3588</u>			

COMPLETE

Date Comm. NOV 9 1955

OTD 3588 CO 5" @ 3566 27 bopd
2 00 bw 2 1/4 3509-1 1/4 frac
Comp. 25 bopd 175 bw

O.W.W.O.

O.W.W.O.

County Sumner Elev. 1211
 Sec. 1 Twp. 35 Rge. 2E
 Company L. C. Smitherman
 FarmName McLaughlin "C" No. 1

Co.

Loc.

No.

Sec.

T.

R.

TOPS	DEPTH	LOG	DATUM	Loc. in Sec.
Anh.				W ¹ / ₄ NE NW
Tr.				
H.	<u>Stal.</u>	<u>2404</u>		
Tr.	<u>Layton</u>	<u>2817</u>		
Dg.	<u>Bart.</u>	<u>3478</u>		
Bl.				
L.				
K.C.				Geol.
B.K.C.				Contr.
Ce.				
C.				
M.	<u>3538</u>			
M.				Pool
K.				<u>Hilltop</u>
Mz.				
Me.				
V.				
S.				
S.				
A.				
R.				
Pe.				
G.				
T.D.	<u>3588</u>			

FIRST REPORT
 OCT 26 55

Date Comm. NOV 9 1955
CO 5" @ 3566 perf. Bart.
test 27 bopd 200 bw T & R