


Section 2 Township 35 Range 2E
 Well No. 1 Lawson
 Company L. C. Smitherman

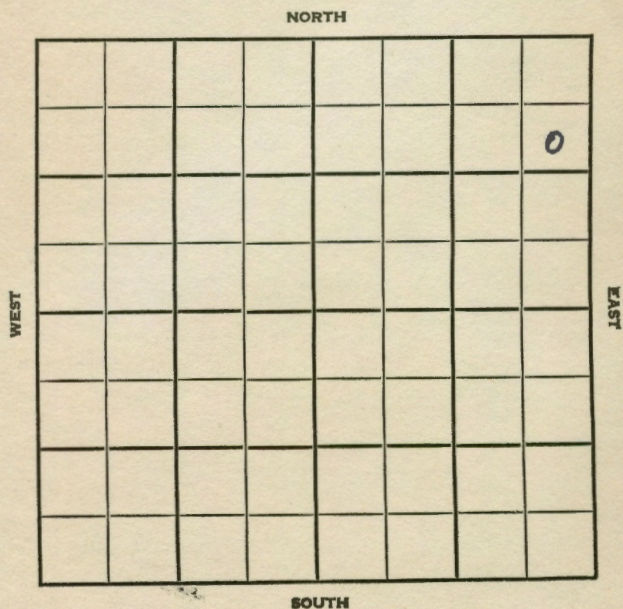

SEC. 2 TWP. 35 R. 2 E
 WELL NO. # 1 Lawson FARM
 COMPANY L. C. Smitherman
 CONTRACTOR Uhl

Hilltop Pool


990 Ft. from N. Line

Ft. from S. Line

330 Ft. from E. Line

Ft. from W. Line

SE NE NE

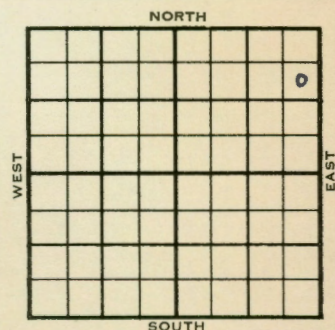

1955

ELEVATION

1216'

REPORT

3/23

Spud 3-19-55

8" @ 104

Drlg. 1460'

4/27

Spud 3-19-55 Oil well TD 3540

8" @ 104 Layton 2795 KC 2997

B KC 3121 Big lime 3203' Bart 3504

DST 3500-30 open 1 hr rec 1200' gas,

105' GCM O# Miss 3535

DST 3 530-40 open 1 hr rec 30' mud

O# TD 3540 4 1/2" @ 3539 CO 24/3509-

15. 1 GOPH frac S/10 BOPH 3 BW

Comp. 25 BOPD

COMPLETED

County Sumner State Kansas
 Sec. 2 (Blk. 35 (Sur. 2E Map No.
 Operator L. C. Smitherman
 Well No. 1 Farm Lawson
 Elev. 1216 Location SE NE NE

990 Ft. From N Line NE
 330 Ft. From E Line Quarter

1st. Report

Completion APR 27 1955Remarks Hilltop PoolUhl - Contr.Spudding Date 3-19-55Drig. Data Oil well TD 35408" @ 104 Layton 2795 KC 2997B KC 3121 Big line 3203 Bart. 3504DST 3500-30 open 1 hr. Rec. 1200' gas105' gcm O# Miss. 3535 DST 3530-40open 1 hr. Rec. 30' mud O# TD 35404 1/2" @ 3539 CO 24/ 3509-15 1 gophfrac S/ 10 boph 3 bwComp. 25 bopd

FABEN GILSTRAP

County Sumner State Kansas
 Sec. 2 (Blk. 35 (Sur. 2E Map No.
 Operator L. C. Smitherman
 Well No. 1 Farm Lawson
 Elev. SE NE NE

990 Ft. From N Line NE330 Ft. From E Line Quarter1st. Report MAR 23 1955

Completion

Remarks

Uhl - Contr.Spudding Date 3-19-55Drig. Data Hilltop Pool8" @ 104 drig. 1460

FABEN GILSTRAP