

DX 78-1

Sumner

KANSAS

2


35

2E

Section _____ Township _____ Range _____

Well No. #2 Lawson

Company Lawson etal

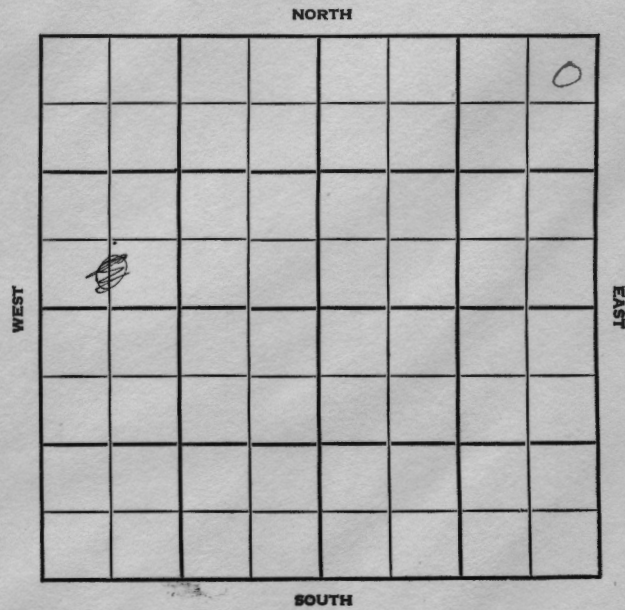

County Sumner Elev. _____
Sec. 2 Twp. 35 Rge. 2E
Company Lawson et al.
Farm Name Lawson No. 2

TOPS	DEPTH	LOG	DATUM	Loc. in Sec.
Anh.				NE NE NE
Tp.				
H.				
Tr.				
Dg.				
Bl.				
L.				Geol.
K.C.				Contr.
B.K.C.				<u>Harold Martin</u>
Ce.				Pool
C.				<u>Murphy</u>
M.				
M.				
K.				
Mz.				
Mo.				
V.				
S.				
S.				
A.				
R.				
Pe.				
G.				
TD				

Date Comm. Cellar & pits

NOV 5 1956

29

County Sumner Elev. 1216 DF
Sec. 2 Twp. 35 Rge. 2E
Company Lawson et al. &
Farm Name Lawson No. 2

TOPS	DEPTH	LOG	DATUM	Loc. in Sec.
Anh.				NE NE NE
Tp.	<u>5211</u>	<u>2370</u>		
H.	<u>624</u>	<u>2801</u>		
Tr.				
Dg.				
Bl.				
L.				Geol.
K.C.		<u>2999</u>		Contr.
B.K.C.				<u>Harold Martin</u>
Ce.	<u>03W</u>	<u>3203</u>		Pool
C.	<u>Bartl.</u>	<u>3511</u>		<u>Murphy</u>
M.				
M.				
K.				
Mz.				
Mo.				
V.				
S.				
S.				
A.				
R.				
Pe.				
G.				
TD		<u>3525</u>		

Date Comm. Cellar & pits NOV 7 '56 11-2-56

858 147/125 # 2216 NOV 13

5/110 3525 NOV 21 '56 CO 3520

8/3510-12 Floc Pop Pld. NOV 20 '56

DEC 3 '56 DEC 12 '56 ✓ DEC 19 '56 ✓ DEC 26 '56

JAN 2 '57 P 25 Bopd + Tr. wtr.