

SEC. 7 TWP. 35 R. 2E

WELL NO.

#1 White

FARM

COMPANY

Alpine Oil & Royalty

CONTRACTOR

Quaker Drlg.

Wildcat.

Ft. from N. Line

330


Ft. from S. Line

Ft. from E. Line

330

Ft. from W. Line

SW SW SW

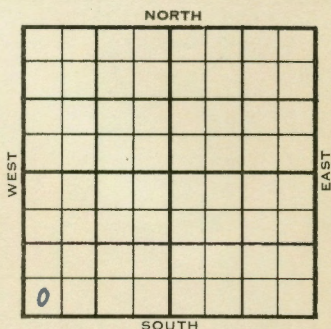

DX 78-1


Sumner KANSAS

Section 7 Township 35 Range 2 E

Well No. #1 White

Company Alpine Oil & Royalty

NORTH

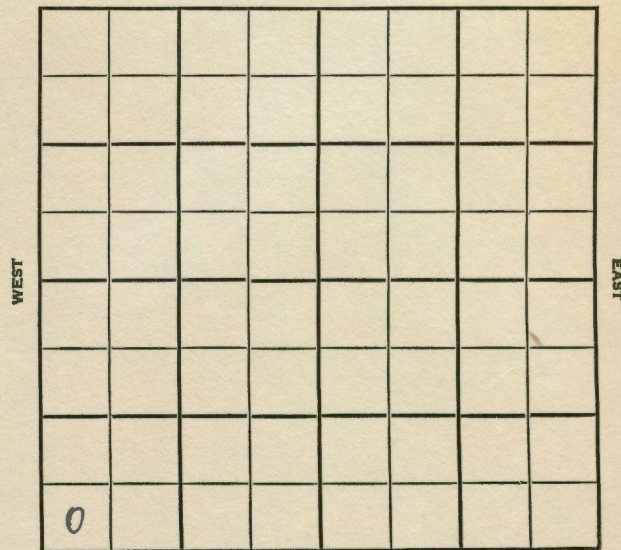


SOUTH

	ELEVATION	REPORT
1955	1093'	
1/5	Spud 12-31-54 8" @ 105' Drlg. 1685'	
1/19	Spud 12-31-54 D & A TD 3520 8" @ 105' Stal. 2382 Layton 2810 DST 2812-40 open 1 hr rec 783' SW 930# KC 3018 Cleve 3105 Oswego 3188 Bart. 3403 Miss. 3472 DST 3474-92 open 1 hr rec 25' mud. 1150# TD 3520 D & A	

ABANDONED

County Sumner State Kansas
 Sec. 7 (Blk. 35 (Sur. 2E Map No.
 (Twp.) (Rge.)
 Operator Alpine Oil & Royalty
 Well No. 1 Farm White
 Elev. 1093 Location SW SW SW

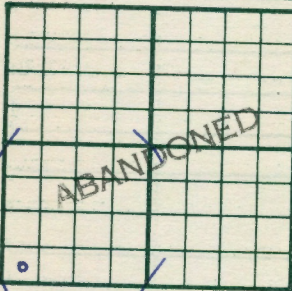

330 Ft. From S Line SW
330 Ft. From W Line Quarter
 1st. Report
 Completion JAN 19 1955
 Remarks Wildcat
Quaker Drlg. - Contr.
 Spudding Date 12-31-54

Drlg. Data D & A TD 3520
8" @ 105 Stal. 2382 Layton 2810

DST 2812-40 open 1 hr. Rec. 783' sw

930# KC 3018 Cleve. 3105 Oswego 3188

Bart. 3403 Miss. 3472 DST 3474-92

open 1 hr. Rec. 25' mud 1150#

TD 3520

D & A

FABEN GILSTRAP

County Sumner State Kansas
 Sec. 7 (Blk. 35 (Sur. 2E Map No.
 (Twp.) (Rge.)
 Operator Alpine Oil & Royalty
 Well No. 1 Farm White
 Elev. Location SW SW SW



330 Ft. From S Line SW
330 Ft. From W Line Quarter
 1st. Report IAN 5 1955
 Completion
 Remarks Quaker Drlg. - Contr.
 Spudding Date 12-31-54

Drlg. Data Wildcat
8" @ 105 drlg. 1685

FABEN GILSTRAP