


Section 8 Township 35 Range 2E
 Well No. #1 Davis
 Company Aylward Drlg.

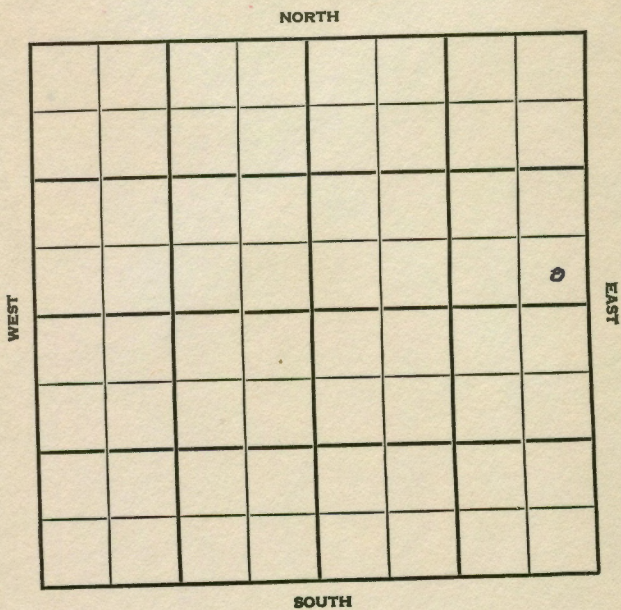

Sumner		KANSAS
SEC.	TWP.	R.
8	35	2 E
WELL NO.		
# 1 Davis		
COMPANY		FARM
Aylward Drlg.		
CONTRACTOR		

NORTH	
_____ Ft. from N. Line	
_____ Ft. from S. Line	
_____ Ft. from E. Line	
_____ Ft. from W. Line	
SE SE NE	
SOUTH	

1955

ELEVATION

1146'

REPORT

5/25

Spud 4-29-55
 8" @ 89 w/100
 DST 2348-56 open 1 hr rec 2' oil,
 13' mud, 30' SW 875/
 DST 3419-32 open 1 hr rec 50' OCM
 725/20#
 5" @ 3418 DD 3431 S/9 BO 24 hr.
 frac. S/9 BO 2 BWPH 3 hr.
 Comp. 25 BOPD 5 BW
 Tops: Stal. 2292', KC 2972',
 Cleve 3077', Osw 3141', Bart 3380'
 Miss. 3395'
 TD 3425'

FIRST REPORT

COMPLETED

**FIRST REPORT
COMPLETED**

FORM 513 REV. SUNRAY

County Sumner Elev. 1146
 Sec. 8 Twp. 35 Rge. 2E
 Company Aylward Drlg.
 Farm Name Davis No. 1

TOPS	DEPTH	DATUM	Loc. in Section
			SE SE NE
Cim. Anhydrite			
Ft. Riley <u>Stal.</u>	<u>2292</u>		
Howard			
Topeka			
Heebner Sh.			
Toronto Ls.			
Brown Lime			
Lansing			
Kans. City	<u>2972</u>	<u>1146</u>	
B. K. C. <u>Cleve.</u>	<u>3077</u>	<u>1931</u>	
Congl. <u>Osw.</u>	<u>3141</u>	<u>1995</u>	
Miss. <u>Bart.</u>	<u>3380</u>	<u>2234</u>	
Kinderhook			
Misener <u>Mias.</u>	<u>3395</u>		
Hunton			
Sylv. Maquo			
Viola			
Simpson			
Smp.			
Gorham			
Arbuckle			
Basal Sand			
Pre. Cam.			
T. D.	<u>3425</u>		

Loc. in Section: SE SE NE

Pool:

Date Comm. _____

Date Comp. MAY 25 '55

Spud 4-29-55 8" @ 89 w/ 100
 DST 2348-56 open 1 hr. Rec. 2' oil
 13' mud 30' sw 875/ DST 3419-32
 open 1 hr. Rec. 50' ocm 725/20#
 5" @ 3418 DD 3431 S/ 9 bo 24 hr.
 frac S/ 9 bo 2 bwph 3 hr.
 Comp. 25 bopd 5 bw