

Section 9 Township 35 Range 2E

Well No. 1 Calander "B" (Callender)

Company Laura Jane Oil

9 35 2 E

WELL NO. # 1 Calander "B" FARM

COMPANY Laura Jane Oil

CONTRACTOR Laura Jane

N. Vernon Pool



Ft. from N. Line

330 Ft. from S. Line

990 Ft. from E. Line

Ft. from W. Line

SW SE SW

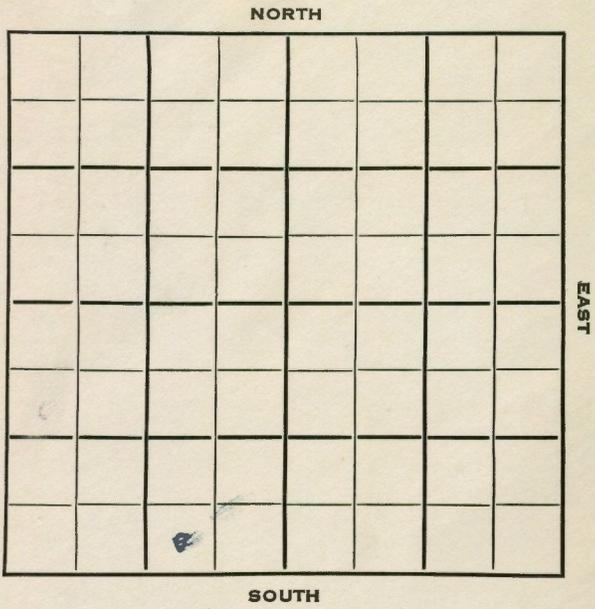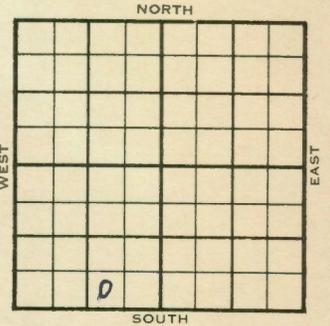

1954 ELEVATION 1117' REPORT

3/3 Spud 2-27-54  
 8" @ 90  
 Drlg. 505'

3/31 Spud 2-27-54 Oil well TD 3382  
 8" @ 90 Layton 2720 KC 2937  
 Miss. 3351 TD 3355 5" @ 3354  
 DD 3382 S & F Comp. 25 BOPD

COMPLETED

