


KANSAS

Section 9 Township 35 Range 2E
 Well No. #2 Callender "B"
 Company Laura Jane Oil

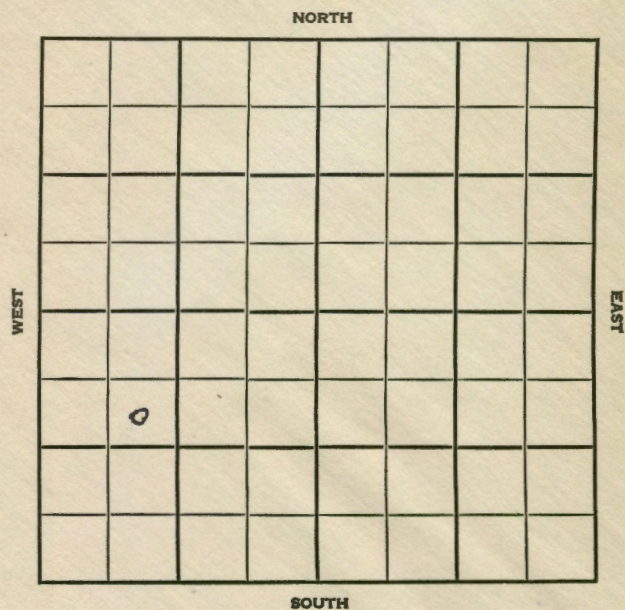

Sumner

SEC. <u>9</u>	TWP. <u>35</u>	R. <u>2E</u>
---------------	----------------	--------------

KANSAS


#2 Callender "B" FARM

COMPANY

Laura Jane Oil

CONTRACTOR

Co. Tools.

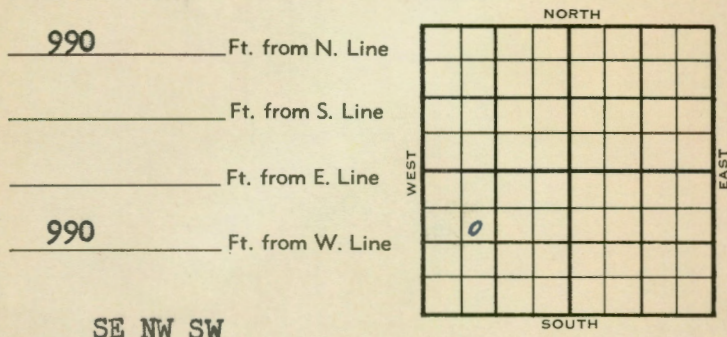

	ELEVATION	REPORT
1954	1144'	
10/20	Spud 10-14-54 10-3/4" @ 98' Drlg. 2318	
11/23	Spud 10-14-54 - Oil Well TD 3426' 10-3/4" @ 98' Stal. 2313', Layton 2742', KC 2945', Oswego 3126', Cherokee 3240', Burgess 3370', Miss 3385' TD 3397' 5" @ 3397' DD 3426' 14 goph frac Comp. 25 bopd	

COMPLETED

FABEN GILSTRAP

FABEN GILSTRAP