


Section 9 Township 35 Range 2E
Well No. #1 Coggins
Company C.H. Daniels

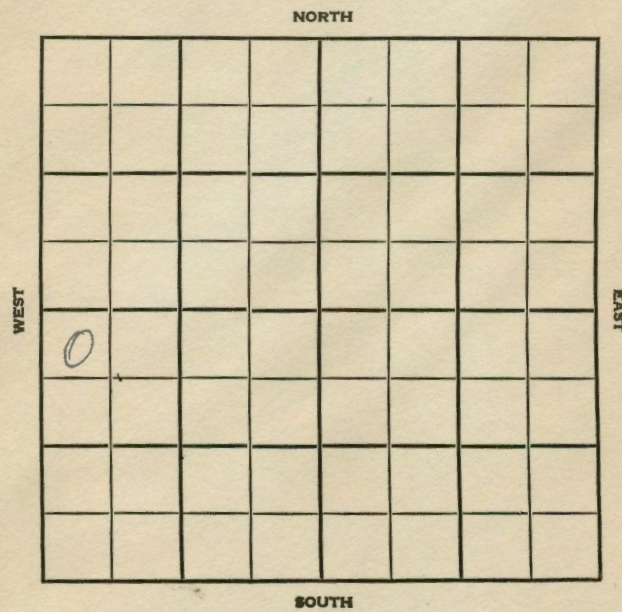

County Sumner Elev. 1146
 Sec. 9 Twp. 35 Rge. 2E
 Company C. H. Daniels
 Farm Name Coggins No. 1

TOPS	DEPTH	LOG	DATUM	Loc. in Sec.
Anh.				NW NW SW
Tr.				
H.				
Tr.				
Dg.				
Bl.				
L.	2226			
K.C.				Geol.
B.K.C.	Stall up 2317-60 (532)			Contr.
Ce.	Stall up 2379-2575 14.5.			Watson Drlg.
C.	U. Log 2740-2872			
M.	L. Log 2860-85			
K.	K.C. 2956			Pool
M.	B.K.C. 3049			Dyal
Mz.	CSW 21 3060-80			
Me.	CSW 3172			
V.	DD 2378-85			
S.	Miss 3992 S.O.			
S.				
A.				
R.				
Pe.				
G.				
TD.	3413			

COMPLETE

JAN 2 '57

Date Comm.

Location 28 50 11-21-56 85/8 1201105 1737 DEC 5 5 1/2 @ 3410

DEC 12 '56 DD DEC 19 '56 ✓ JAN 2 '57

DD 3450 Frac P. EST20 Bopd + 60 Bwpd.

County Sumner Elev. 1146
 Sec. 9 Twp. 35 Rge. 2E
 Company C. H. Daniels
 Farm Name Coggins No. 1

TOPS	DEPTH	LOG	DATUM	Loc. in Sec.
Anh.				NW NW SW
Tr.				
H.				
Tr.				
Dg.				
Bl.				
L.				
K.C.				Geol.
B.K.C.				Contr.
Ce.				Watson Drlg.
C.				
M.				
M.				Pool
K.				Dyal
Mz.				
Me.				
V.				
S.				
S.				
A.				
R.				
Pe.				
G.				
TD.				

NOV 21 '56

FIRST REPORT

Date Comm.

Location

24