


Section 9 Township 35S Range 2E

Well No. #3 Callendar "B"

Company Laura Jane

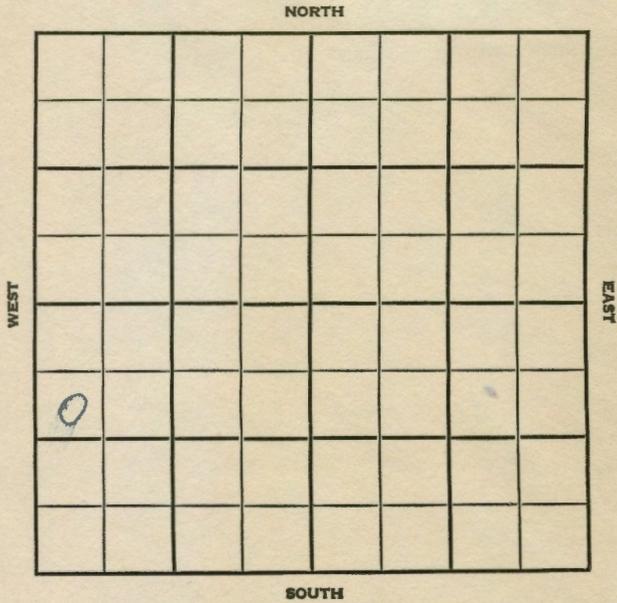

SEC. 9 TWP. 35 R. 2E

WELL NO. #3 Callendar "B" FARM

COMPANY Laura Jane

CONTRACTOR


Vernon No.

\_\_\_\_\_ FT. FROM N. LINE

\_\_\_\_\_ FT. FROM S. LINE

\_\_\_\_\_ FT. FROM E. LINE

\_\_\_\_\_ FT. FROM W. LINE

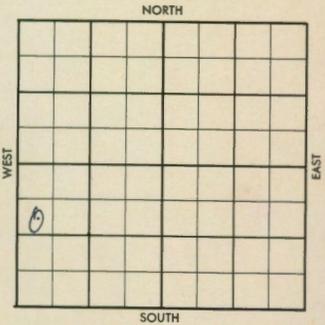

SW NW SW

1956 ELEVATION 1147' REPORT

6-13 Location

7-18 Comm. 6-12-56  
 8 5/8" @ 95 w/130  
 5 1/2" @ 3387 w/60  
 CO 3393  
 SI 12 hrs.  
 Flw 20 BOPH, no time  
 Flow 25 BOPD, no wtr.  
 Lotan 2267'; Stall 2311'; Li. 2944';  
 Osw. 3113'; Burg 3354'; M. Chat 3374'  
 TD 3393

COMPLETED

