


DX 78-1 Sumner

KANSAS

Section 9 Township 35S Range 2E

Well No. #5 Callendar "B"

Company Laura Jane Oil

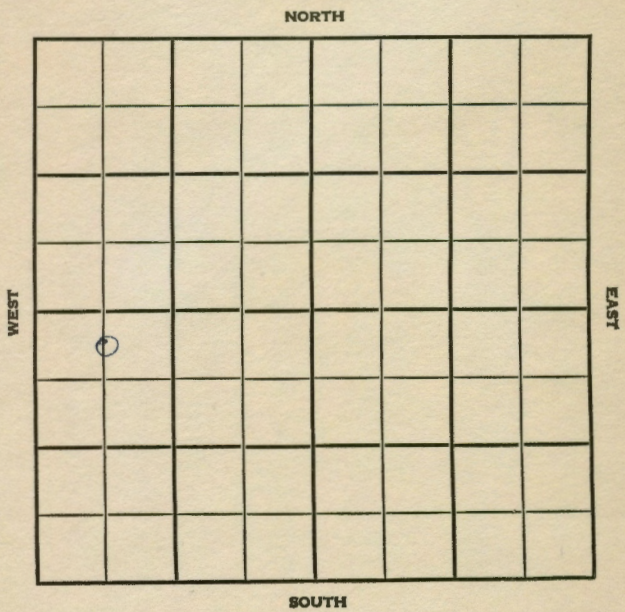

SEC.	TWP.	R.
9	35	2E

WELL NO. _____

#5 Callendar "B"

FARM

COMPANY _____

Laura Jane Oil

CONTRACTOR _____

Co.

Vernon No.


_____ FT. FROM N. LINE

_____ FT. FROM S. LINE

_____ FT. FROM E. LINE

_____ FT. FROM W. LINE

$N\frac{1}{2}$ NW SW

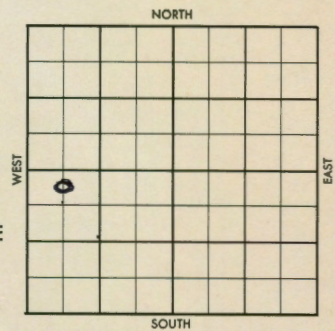

	ELEVATION	REPORT
1956		

8-29

Comm. 8-23-56
8" @ 100 w/135
Drlg. 2050

County Sumner Elev. 1155 DF
 Sec. 9 Twp. 35S Rge. 2E
 Company Laura Jane Oil
 FarmName Callendar "B" No. 5

TOPS	DEPTH	LOG	DATUM	Loc. in Sec.
Anh				<u>N$\frac{1}{2}$ NW SW</u>
Tp. <u>10tan</u>	<u>2255</u>			
H. <u>stall</u>	<u>2326</u>			
Tr. <u>ldy</u>	<u>2757</u>			
Dg.				
Bl.				
L.				<u>Don Shawver</u>
K.C.	<u>2968</u>			Geol.
B.K.C. <u>osw</u>	<u>3141</u>			Contr.
Ce. <u>Borg</u>	<u>3388</u>			<u>Co.</u>
C.				
M.	<u>3406</u>			Pool
M.				<u>Vernon No.</u>
K.				
Mz.				
Mo.				
V.				
S.				
S.				
A.				
R.				
PE.				
G.				
TD.	<u>3428</u>			

Date Comm. 8-23-56
8" 100 w/135; D 2050 SEP 5 '56 5 1/2 @ 3420
 SEP 12 '56 SEP 19 '56 SEP 26 '56 DD. 3429
Frac estl. 50 Bopd natu

County Sumner Elev. _____
 Sec. 9 Twp. 35S Rge. 2E
 Company Laura Jane Oil
 FarmName Callendar "B" No. 5

TOPS	DEPTH	LOG	DATUM	Loc. in Sec.
Anh				<u>N$\frac{1}{2}$ NW SW</u>
Tp.				
H.				
Tr.				
Dg.				
Bl.				
L.				<u>Don Shawver</u>
K.C.				Geol.
B.K.C.				Contr.
Ce.				<u>Co.</u>
C.				
M.				Pool
M.				<u>Vernon No.</u>
K.				
Mz.				
Mo.				
V.				
S.				
S.				
A.				
R.				
PE.				
G.				
TD.				

Date Comm. 8-23-56
8" 100 w/135; D 2050
 FIRST REPORT
 AUG 29 '56

291
 SEP 2 1956
 R.G.