



SEC. 2	TWP. 35	R. 2E
--------	---------	-------

Section 2 Township 35 Range 2E  
 Well No. 1 McLaughlin "D" (McLaughlin)  
 Company L. C. Smitherman

WELL NO. #1 McLaughlin "D" FARM  
 COMPANY L. S. Smitherman  
 CONTRACTOR Co. Tools

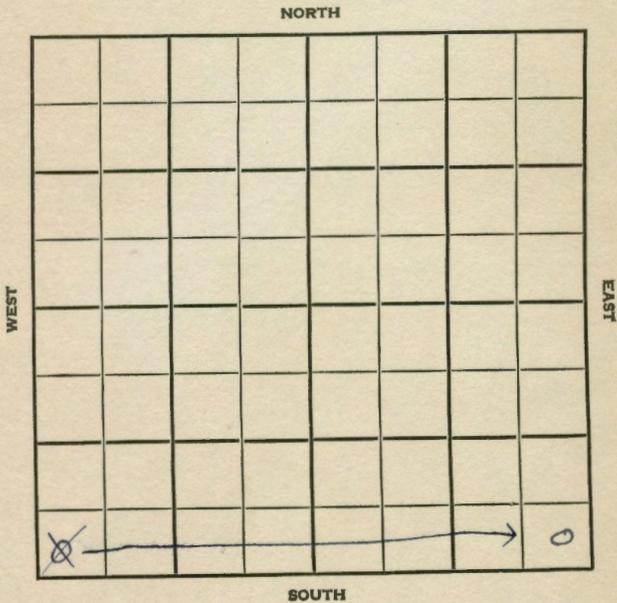

State Line  
 \_\_\_\_\_ Ft. from N. Line  
330 Ft. from S. Line  
330 Ft. from E. Line  
 \_\_\_\_\_ Ft. from W. Line

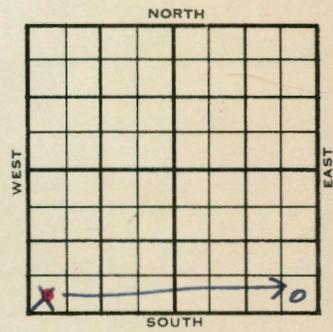

~~SW SW SW~~ ~~SE SE SE~~  
 Tite Hole

	ELEVATION	REPORT
1955	1205'	
7/20	Drlg.	
8/10	TD 3553 D&A	H. Stal: 2352, 1147; Tr. Layton 2794, 1589, KC: 2990, 1785; Ce. Oswego: 3197, 1992, M Bart: 3485, 2280; M. 3538, 2333; TD 3553.

**ABANDONED**

County Sumner Elev. 1205  
 Sec. 2 Twp. 35 Rge. 2E  
 Company L. C. Smitherman  
 FarmName McLaughlin "D" No. 1

TOPS	DEPTH	LOG	DATUM	Loc. in Sec.
Anh.				SE SE SE
TP.				
H. <u>Stal</u>	<u>2352</u>		<u>1/47</u>	
Tr. <u>Layton</u>	<u>2794</u>		<u>1/584</u>	
Dg.				
Bl.				
L.				
K.C.	<u>2990</u>		<u>1765</u>	Geol.
B.K.C.				Contr.
Ce. <u>Osage</u>	<u>3197</u>		<u>1992</u>	Co. tools
C.				
M. <u>Bent</u>	<u>3485</u>		<u>2280</u>	Pool
M.	<u>3538</u>		<u>2333</u>	State Line
K.				
Mz.				
Me.				
V.				
S.				
S.				
A.				
R.				
Pe.				
G.				
TD.	<u>3553</u>			

Date Comm. AUG 10 1955  
 TD 3553  
 D & A

County Sumner Elev. \_\_\_\_\_  
 Sec. 2 Twp. 35 Rge. 2E  
 Company L. C. Smitherman  
 FarmName McLaughlin "D" No. 1

TOPS	DEPTH	LOG	DATUM	Loc. in Sec.
Anh.				SW SW SW
TP.				
H.				
Tr.				
Dg.				TITE HOLE
Bl.				
L.				
K.C.				Geol.
B.K.C.				Contr.
Ce.				Co. tools
C.				
M.				Pool
M.				State Line
K.				
Mz.				
Me.				
V.				
S.				
S.				
A.				
R.				
Pe.				
G.				
TD.				

Date Comm. drlg.  
 JUL 20 '55  
 FIRST REPORT

SCOUT TICKET DX-201 Kansas

SEC. 2 TWP. 35 R. 2E

WELL NO. 1 McLaughlin "D" FARM

COMPANY L. C. Smitherman

CONTRACTOR CORRECTION


SE SE SE

\_\_\_\_\_ FT. FROM N. LINE

330 FT. FROM S. LINE

330 FT. FROM E. LINE

\_\_\_\_\_ FT. FROM W. LINE

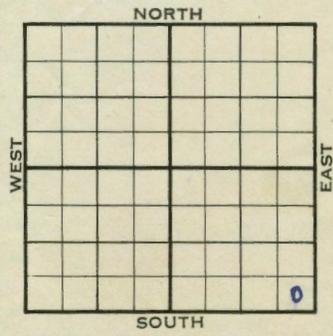

Summer County

LOCATION  
 RIG UP  
 DRILLING AND REMARKS:

Reported  
 SW SW SW

RECORD	CASED	IN.,	FT.
	SAND		
	GAS		
	OIL		
PRODUCTION	TOTAL DEPTH		
	1ST 24 HRS. NAT.		
	1ST 24 HRS. AFTER SHOT		
	GAS		CU. FT.
	DRY HOLE		
ABANDONED			

DATE JUL 27 1955

SCOUT L. J. Harris