

Section 3 Township 35 Range 2 E

Well No. # 1 Fitch



Company Laura Jane

SEC. 3 TWP. 35 R. 2 E

WELL NO. # 1 Fitch FARM

COMPANY Laura Jane

CONTRACTOR _____

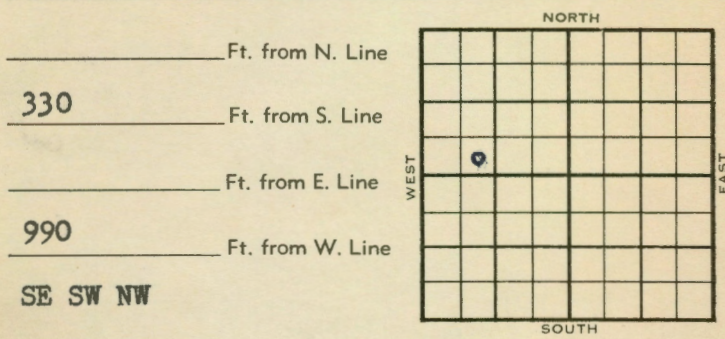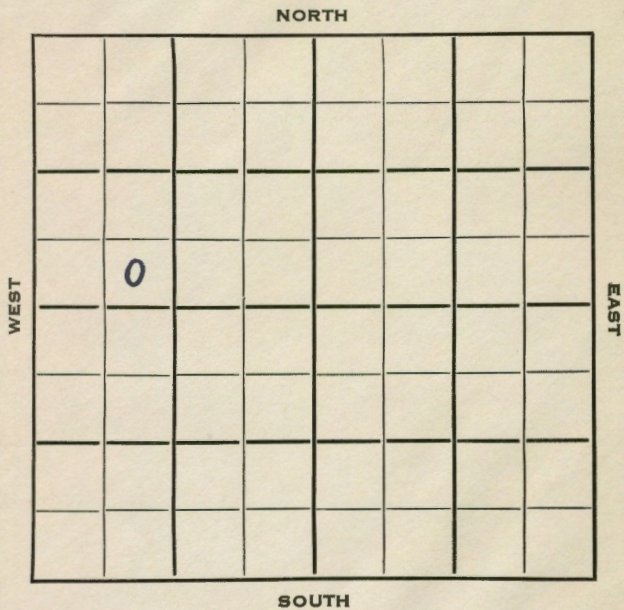

	ELEVATION	REPORT
1953	1171'	
9/16	Spud 9-15-53 8" @ 60 WOC	
10/14	Spud 9-15-53 D & A TD 3467' 8" @ 60' Stal. 2337', Layton 2764, Miss 3420, TD 3426' 5" @ 3425' DD 3467 sd-frac wtr. D & A	

ABANDONED

