



Section 3 Township 35 Range 2E  
 Well No. #1 McIrwin "A"  
 Company Aladdin Petr.

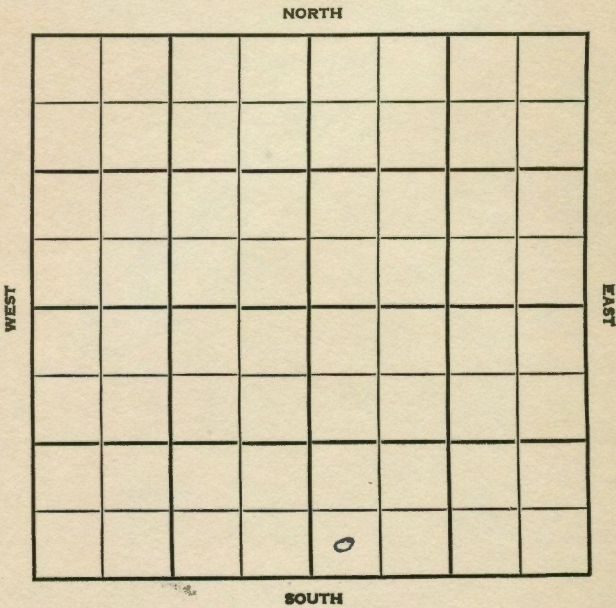

SEC. 3 TWP. 35 R. 2E  
 WELL NO. 1 McIrwin "A" FARM  
 COMPANY Aladdin Petr.  
 CONTRACTOR Crowe

Semi Wildcat  
 \_\_\_\_\_ Ft. from N. Line  
330 \_\_\_\_\_ Ft. from S. Line  
 \_\_\_\_\_ Ft. from E. Line  
330 \_\_\_\_\_ Ft. from W. Line

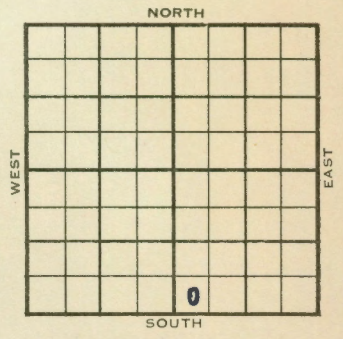

SW SW SE

	ELEVATION	REPORT
1955	<b>1190'</b>	
4/6	Spud 3-3-55 8" @ 137' Drlg. 1700'	
4/20	Spud 3-3-55 D & A TD 3795 8" @ 137' <b>Stal. 2370'</b> <b>Layton 2788</b> DST 2788-93 open 1 hr rec 45' wtr. 5' VSOCM <b>Bart 3437</b> <b>Miss 3482</b> DST 3489-3500 open 1 hr rec 780' gas, 20' mud 610# DST 3503-18 open 1 hr rec 37' mud 215# <b>Simp. 3693'</b> DST <del>3695</del> -3706, open 1/2 hr rec 380' mud 1495#. DST 3704-47, open 1/2 hr rec 120' mud, 720' SW 1345# <b>Arb. 3767</b> DST <del>3766</del> -73 open 20 min, rec 7' WCM 1495# TD 3795' D & A	
	<b>ABANDONED</b>	

