


Section 3 Township 35 Range 2E
Well No. #1 Olson
Company Thrifty Drlg.

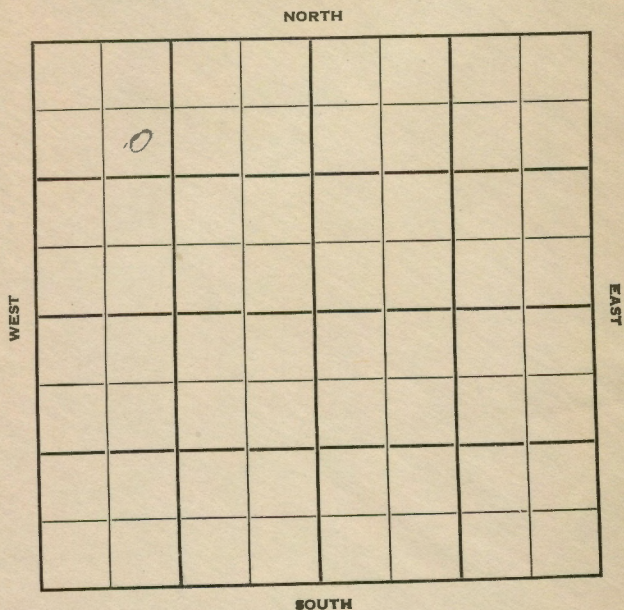


Sec. 3 Twp. 35 R. 2E
Well No. #1 Olson Farm
Thrifty Drlg. Company
Contractor

Padgett Pool

990' Ft. from N. Line
Ft. from S. Line
Ft. from E. Line
990' Ft. from W. Line

SE NW NW

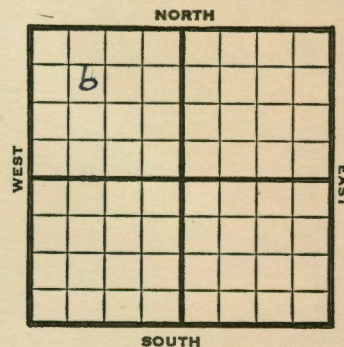

1950 **Elev 1182'** REPORT

2/8 Spud 2-6-50
Drlg.
3/22 8" @ 108'
Miss 3435-43'
5" @ 3439'
TD 3475'
20 qts 3460-75'
Fill up 1000' oil 12 hrs.
Comp 25 BOPD
Comp

COMPLETED

Map No. _____ Sec. 3 Twp. 35 R. 2E

Well No. 1 Olson

Thrifty Drlg. _____ Company

Contractor _____

SE NW NW

EI. 1182

SECTION PLAT

990 Ft. from N. Line

_____ Ft. from S. Line

_____ Ft. from E. Line

990 Ft. from W. Line

| | | | |
|---|--|--|--|
| o | | | |
| | | | |
| | | | |
| | | | |
| | | | |

Sumner County

Location _____

Rig up _____

Drilling and Remarks:

8" @ 108
 Miss. 3435-43
 5" @ 3439
 T.D. 3475
 20 gal. 3460-75
 Fill up 1000' oil
 12 hrs.
 Comp 35 bopd

RECORD

Cased _____ in., _____ ft.

Sand _____

Gas _____

Oil _____

Total Depth _____

PRODUCTION

1st 24 hrs. Nat. _____

1st 24 hrs. after shot _____

Gas _____ Cu. Ft.

Dry Hole _____

Abandoned _____

Date _____

MAR 22 1950 19

J. E. TYRA Scout

Map No. _____ Sec. 3 Twp. 35 R. 2E

Well No. 1 Olson

Thrifty Drlg. _____ Company

Contractor _____

SE NW NW

SECTION PLAT

990 Ft. from N. Line

_____ Ft. from S. Line

_____ Ft. from E. Line

990 Ft. from W. Line

| | | | |
|---|--|--|--|
| o | | | |
| | | | |
| | | | |
| | | | |
| | | | |

Sumner County

Location _____

Rig up _____

Drilling and Remarks:

Spud 2-6-50

drlg.

RECORD

Cased _____ in., _____ ft.

Sand _____

Gas _____

Oil _____

Total Depth _____

PRODUCTION

1st 24 hrs. Nat. _____

1st 24 hrs. after shot _____

Gas _____ Cu. Ft.

Dry Hole _____

Abandoned _____

Date _____

FEB 8 1950 19

J. E. TYRA Scout