


Section 9 Township 35 Range 2-E

Well No. #1 Callender

Company E. E. Sawyer
Vernon Pool

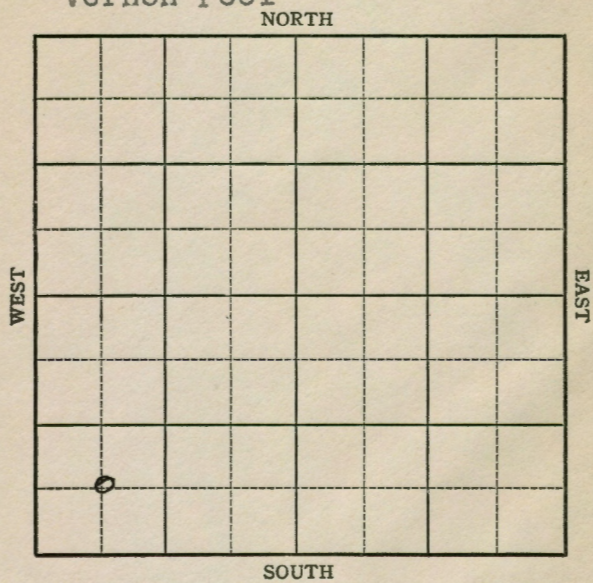

Sec. 9 Twp. 35 R. 2-E

Well No. #1 Callender Farm

E. B. Sawyer Company


(Vernon Pool)

_____ Ft. from N. Line

660 Ft. from S. Line

_____ Ft. from E. Line

660 Ft. from W. Line

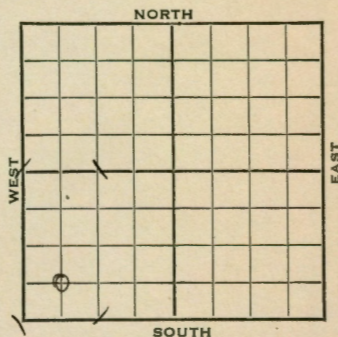

1942

REPORT

8/27

Rotary.

9/2

10" - 75' Drlg. 1650

9/9

Lans 2995 Drlg 3255

9/16

Miss. 3357

5" - 3357

Flow 50 pot.

T.D. 3405

Gravity 39.

COMPLETED

Sumner

KANSAS

Map No. / Sec. 9 Twp. 35 R. 2E

Well No. 1 Callender

E. B. Shawver Company

COMPLETED Contractor

C SW SW

SECTION PLAT

Ft. from N. Line

660 Ft. from S. Line

Ft. from E. Line

660 Ft. from W. Line

VERNON POOL

Location

Rig up

Drilling and Remarks:

Miss 3357
 5" @ 3357
 Flow 500 gpd
 37 gpd

RECORD

Cased in, ft.
 Sand
 Gas
 Oil
 Total Depth 3405

PRODUCTION

1st 24 hrs. Nat.
 1st 24 hrs. after shot
 Gas Cu. Ft.
 Dry Hole
 Abandoned

Date

SEP 16 1942 19

S. J. LEWIS Scout

Sumner

KANSAS

Map No. / Sec. 9 Twp. 35 R. 2E

Well No. 1 Callender

E. B. Shawver Company

FIRST REPORT Contractor

C SW SW

SECTION PLAT

Ft. from N. Line

660 Ft. from S. Line

Ft. from E. Line

660 Ft. from W. Line

VERNON POOL

Location

Rig up

Drilling and Remarks:

Rotary

RECORD

Cased in, ft.
 Sand
 Gas
 Oil
 Total Depth

PRODUCTION

1st 24 hrs. Nat.
 1st 24 hrs. after shot
 Gas Cu. Ft.
 Dry Hole
 Abandoned

Date

AUG 27 1942 19

S. J. LEWIS Scout