

Summer


FORM 51 5M BRIX

KANSAS

Section 11 Township 35 Range 2E

Well No. #1, Wood-Anderson

Company Ben Galapp

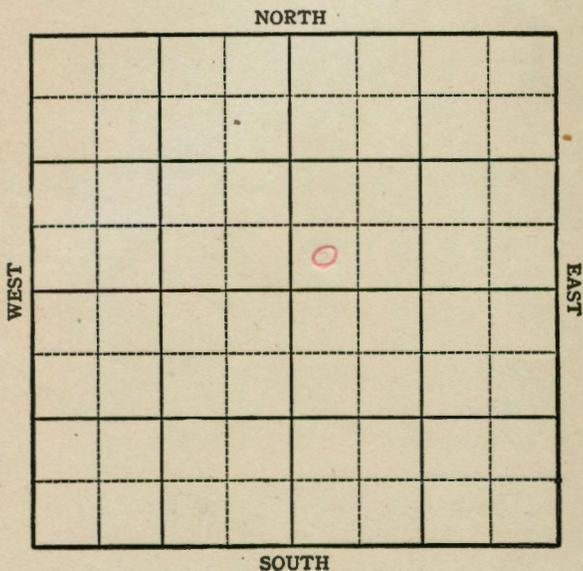

FORM 252-KANSAS
5M 3-44 PETROL

Summer County

Sec. 11 Twp. 35 R. 2E

Well No. #1 Wood-Anderson Farm

Ben Galapp Company


Miscellaneous

_____ Ft. from N. Line

330 Ft. from S. Line

_____ Ft. from E. Line

330 Ft. from W. Line

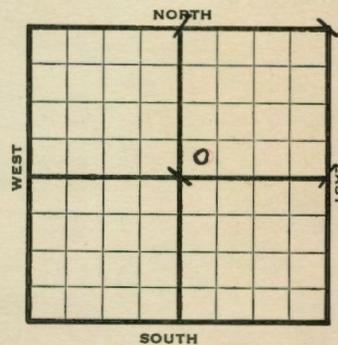

Elev. 1213

1944

REPORT

7/12 Rotary
 7/19 Surface Hole
 7/26 8" @ 167 Drlg. 1315
 8/2 Drlg. 2626
 8/9 Drlg. 3250
 8/16 Miss 3507
 Drlg. 3615
 8/23 B Miss 3742
 Simp Sd 3795
 TD 3797 Run 5"
 8/30 5" @ 3793 RUST
 9/8 TD 3804' SSO
 9/13 " " "
 9/20 Simp 3793
 5" @ 3793
 TD 3804

ABANDONED

KANSAS

Pool Name Miscellaneous

Map No. 1 Sec. 11 Twp. 35 R. 2E


Well No. 1 Wood-Anderson

Ben Gralapp Company

ABANDONED Contractor

SW NE

SECTION PLAT

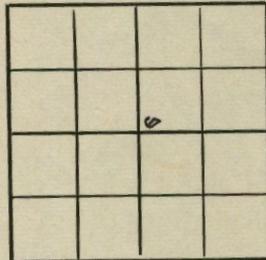

_____ Ft. from N. Line

330 Ft. from S. Line

_____ Ft. from E. Line

330 Ft. from W. Line

Sumner County

Location _____

Rig up _____

Drilling and Remarks:

*Drill 3798
5103788*

RECORD

Cased _____ in., _____ ft.

Sand _____

Gas _____

Oil _____

Total Depth 3804

PRODUCTION

1st 24 hrs. Nat. _____

1st 24 hrs. after shot _____

Gas _____ Cu. Ft.

Dry Hole _____

Abandoned _____

Date

SEP 20 1944 19

S. J. LEWIS Scout

KANSAS

Pool Name Miscellaneous

Map No. 1 Sec. 11 Twp. 35 R. 2E


Well No. 1 Wood-Anderson

Ben Gralapp Company

FIRST REPORT Contractor

SW NE

SECTION PLAT

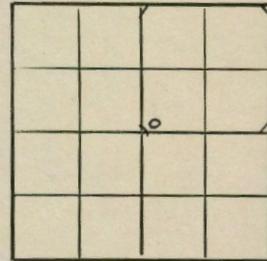

_____ Ft. from N. Line

330 Ft. from S. Line

_____ Ft. from E. Line

330 Ft. from W. Line

Sumner County

Location _____

Rig up _____

Drilling and Remarks:

Rotary

RECORD

Cased _____ in., _____ ft.

Sand _____

Gas _____

Oil _____

Total Depth _____

PRODUCTION

1st 24 hrs. Nat. _____

1st 24 hrs. after shot _____

Gas _____ Cu. Ft.

Dry Hole _____

Abandoned _____

Date

JUL 12 1944 19

S. J. LEWIS Scout