


Section 9 Township 35 Range 2 E

Well No. # 1 Coggins

Company O. H. Parker

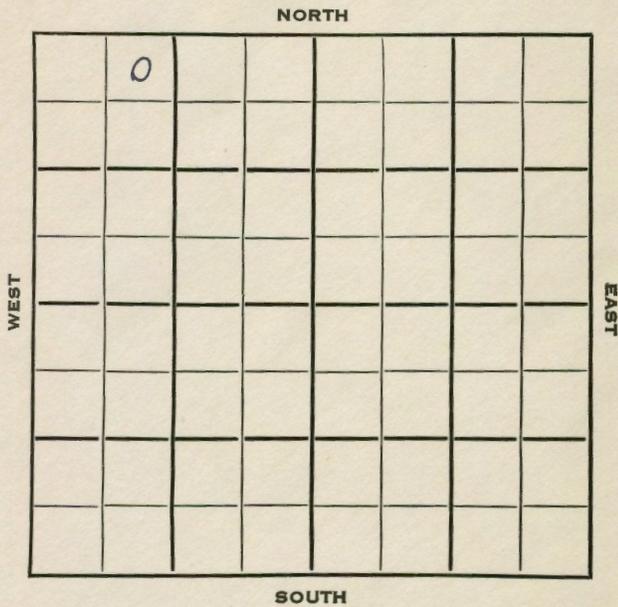

SEC.	TWP.	R.
9	35	2E

WELL NO. 1 Coggins FARM

COMPANY O. H. Parker

CONTRACTOR Martin & Cash


Semi-Wildcat

330 Ft. from N. Line

_____ Ft. from S. Line

_____ Ft. from E. Line

990 Ft. from W. Line

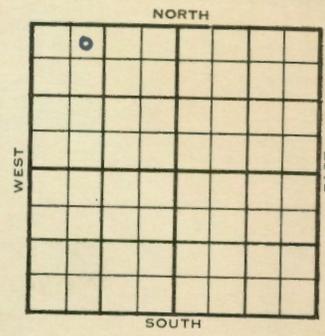

NE NW NW

1953	ELEVATION	REPORT
	<u>1164'</u>	

12/2 Cellar & Pits

1954
3/31

Spud 12-1-53 Oil well TD 3163
8" @ ? **Stal. 2336 Layton 2777**
KC 2970 Cleveland 3068-85
Oswego 3148 TD 3163 6" @ 3163
72/3083-98 SO & G frac. wtr.
PB 2420 8/2356-58 28/2336-43
36/2356-65 sd-oil-frac.
Comp. 22 BOPD

COMPLETED

County Sumner State Kansas
 Sec. 9 (Blk. Twp.) 35 (Sur. Rge.) 2E Map No.

Operator O. H. Parker
 Well No. 1 Farm Coggins

Elev. 1164 Location NE NW NW

330 Ft. From N Line NW
990 Ft. From W Line Quarter

1st. Report _____

Completion MAR 31 1954

Remarks Semi-Wildcat

Martin & Cash - Contr.

Spudding Date 12-1-53

Drlg. Data Oil well 1 TD 3163

8" @ Stal. 2336 Layton 2777


KC 2970 Cleveland 3068-85 Oswego 3148

TD 3163 6" @ 3163 72/ 3083-98 SO & G

frac wtr. PB 2420 8/ 2356-58

28/ 2336-43 36/ 2356-65 sd-oil-frac

Comp. 22 bopd

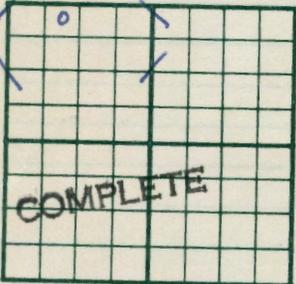

J. G. McGEHEE

County Sumner State Kansas
 Sec. 9 (Blk. Twp.) 35 (Sur. Rge.) 2E Map No.

Operator O. H. Parker
 Well No. 1 Farm Coggins

Elev. _____ Location NE NW NW

330 Ft. From N Line NW
990 Ft. From W Line Quarter

1st. Report DEC 2 1953

Completion _____

Remarks _____

Martin & Cash - Contr.

Spudding Date _____

Drlg. Data Semi-Wildcat

Cellar & pits



J. G. McGEHEE