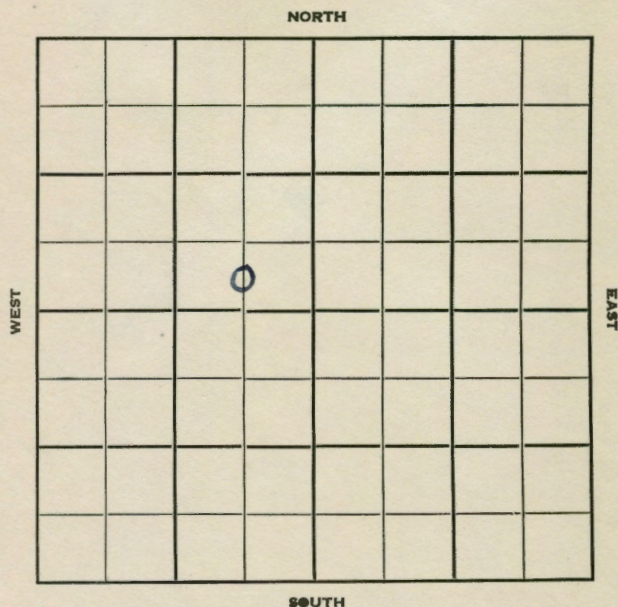



Section 9 Township 35 Range 2 EWell No. # 1 GrantCompany Laura Jane OilSec. 9 Twp. 35 R. 2 EWell No. # 1 Grant FarmLaura Jane Oil CompanyCapitt Drlg. Contractor

Ft. from N. Line

330 Ft. from S. Line660 Ft. from E. Line

Ft. from W. Line

C S L SE NW

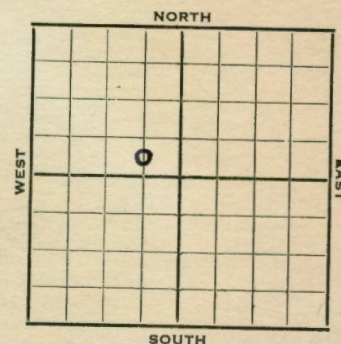

1952

Elev. 1136 REPORT

7/9 Surface set

7/17 8" @ 81
Drlg. 540'7/23 Stal 2443 Lay 2737
KC 2957 Osw 3131
Drlg. 3337'

8/6 D&A Hold

8/13 "

8/20 Spud 7-12-52
D&A TD 3448
8" @ 81

Stal 2443 Layton 2737

KC 2957 Oswego 3131


Miss 3405 TD 3448

D&A

ABANDONED

3131
1136
1995

County Sumner State Kansas
 Sec. 9 (Blk. 35 (Sur. 2E Map No.
 Operator Laura Jane Oil
 Well No. 1 Farm Grant
 Elev. 1136 Location C S L SE NW

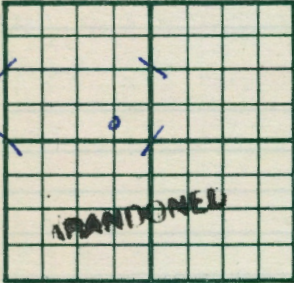

330 Ft. From S Line NW
660 Ft. From E Line Quarter

1st. Report


Completion AUG 20 1952

Remarks

Cappit - Contr.Spudding Date 7-12-52Drig. Data D & A TD 34488" @ 81 Stal. 2443 Layton 2737KC 2957 Oswego 3131 Miss. 3405TD 3448D & A

J. G. McGEHEE

County Sumner State Kansas
 Sec. 9 (Blk. 35 (Sur. 2E Map No.
 Operator Laura Jane Oil
 Well No. 1 Farm Grant
 Elev. Location C S L SE NW

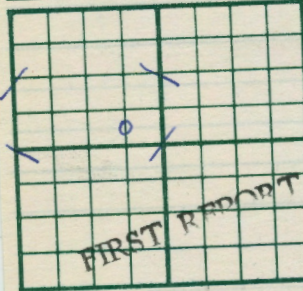330 Ft. From S Line NW660 Ft. From E Line Quarter

1st. Report

JUL 9 1952

Completion

Remarks

Capitt Drig. - Contr.

Spudding Date

Drig. Data

surface set

J. G. McGEHEE