


KANSAS

Section 9 Township 35 Range 2-E

Well No. #1-A Wentworth

Company Greeley Drlg.

NORTH

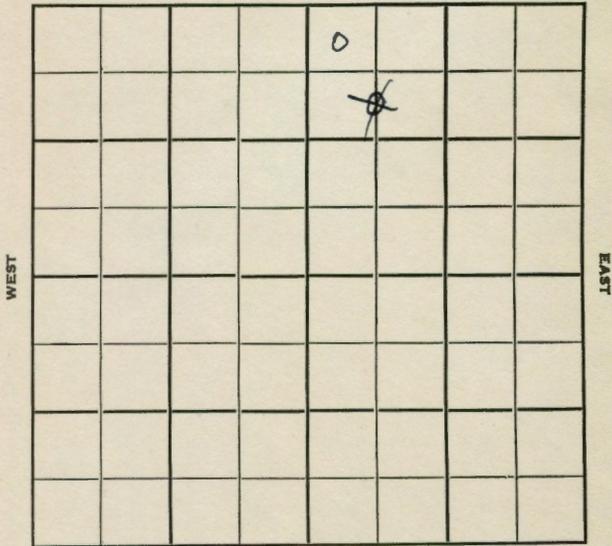

SOUTH

KANSAS

Sec. 9 Twp. 35 R. 2-E

Well No. #1-A Wentworth Farm _____

Greeley Drlg. Company _____

Contractor _____

Padgett
330 990 Ft. from N. Line

_____ Ft. from S. Line

_____ Ft. from E. Line

660 330 Ft. from W. Line

NW
SE NW NE

Irwin Well

NORTH



SOUTH

1951

Elev 1129' REPORT

1/3 Spud 12-28-50
Drlg 1965'

1/24 Spud 12-28-50
8" @ 60

Stal 2315

Chat 3384

TD 3430

5" @ 3385

water

D&A

ABANDONED

Layton 2705

$$\begin{array}{r}
 3384 \\
 1129 \\
 \hline
 2255
 \end{array}$$

County Sumner State Kansas
Sec. 9 (Blk. 35 (Sur. 2E Map No.

Operator Greeley Drlg.
Well No. 1-A Farm Wentworth

Elev. 1129 Location NW NW NE (twin well)



330 Ft. From N Line NE

330 Ft. From W Line Quarter

1st. Report

Completion JAN 24 1951

Remarks Padgett Pool

Spudding Date 12-28-50

Drlg. Data D & A TD 3430

8" @ 60 Stal. 2315 Layton 2705

Chat 3384 TD 3430 5" @ 3385 water

D & A

J. E. TYRA


County Sumner State Kansas

Sec. 9 (Blk. 35 (Sur. 2E Map No.

Operator Greeley Drlg.

Well No. 1-A Farm Wentworth

Elev. Location C S L NW NE

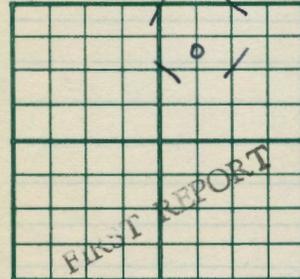

990 Ft. From N Line NE

660 Ft. From W Line Quarter

1st. Report JAN 3 1951

Completion

Remarks

Spudding Date 12-28-50

Padgett Pool

Drlg. Data

drlg. 1965

J. E. TYRA

Kansas

Map No. _____ Sec. 9 Twp. 35 R. 2E

Well No. 1-A Wentworth

Greeley Drlg. Company

CORRECTION Contractor

NW NW NE (twin well)


SECTION PLAT

330 Ft. from N. Line

_____ Ft. from S. Line

_____ Ft. from E. Line

330 Ft. from W. Line

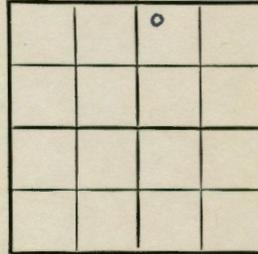

Sumner County

Location _____

Rig up _____

Drilling and Remarks:

Reported

C S L NW NE

RECORD

Cased _____ in., _____ ft.

Sand _____

Gas _____

Oil _____

Total Depth _____

PRODUCTION

1st 24 hrs. Nat. _____

1st 24 hrs. after shot _____

Gas _____ Cu. Ft.

Dry Hole _____

Abandoned _____

Date

JAN 24 1951 19

J. E. TYRA Scout