


Map No. KANSAS Sec. 10 Twp. 35 R. 2EWell No. 1 Buffington Farm
Ben Hollop et al Company

NORTH

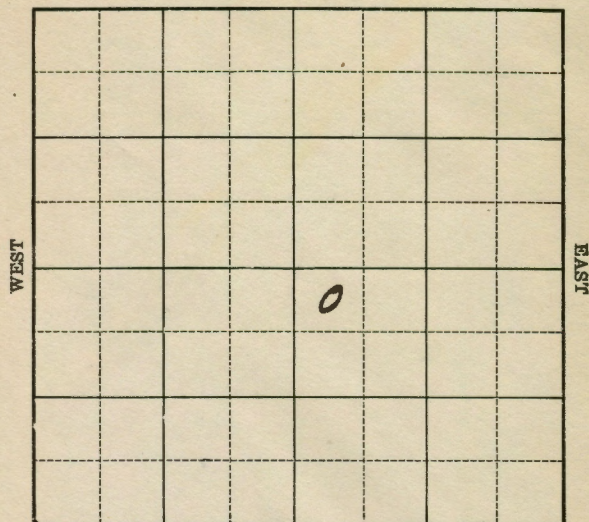

SOUTH

Location
Drilling RemarksRig Up
Drilling Remarks

RECORD

Cased _____ in. _____ ft.
 Sand _____
 Gas _____
 Oil _____
 Total Depth _____

PRODUCTION

1st 24 hrs. Nat. _____
 1st 24 hrs. after shot _____
 Gas _____ cu. ft.
 Dry Hole _____
 Abandoned _____


Map No. KANSAS Sec. 10 Twp. 35 R. 2EWell No. 1 Buffington Farm
Ben Hollop et al Company

NORTH

330 Ft. from N. Line

Ft. from S. Line

Ft. from E. Line

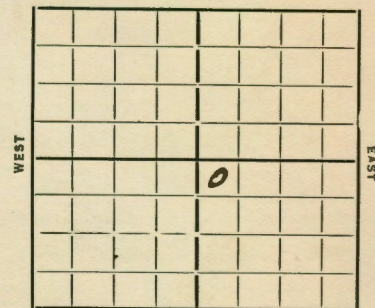330 Ft. from W. Line

SOUTH

Date

REPORT

11/7 Cellar
11/15 Bldg
11/22 —
11/28 Rgn
12/6 Dlg 123
12/13 " 710
12/21 " 1106
12/27 1267 5D 12"
1/3/35 — 1/10 —
1/17 12" 1267 TD 1315 Pull 15"
1/24 1900 Rig Burned
1/31 —
2/7 Dlg 1875
2/14 10" 2037
2/21 —
2/28 Dlg 2500
3/7 " 2910
3/14 6" 3171
3/21 Part S. 3425 S.O. 3425-30
3/28 Chit 3464 S.O. 3480 Dlg 3493
4/4 — 4/11 —

(OVER)

4/18 HFW 3575-78 Dly 3582

4/26 —

5/2 3586 fag

5/9 — 5/16 — 5/23 — 5/29 — 6/6 —

6/13 — 6/20 —

6/28 Dly 3598 in chat

7/3 HFW 3606 to 3612-20

HFW 3625

W.R. 5" 3643

7/11 5" 3641

7/17 Sil 3790

TJ 3794

D. & A.

ABANDONED

KANSAS

Map No. 1 Sec. 10 Twp. 35 R. 2EWell No. 1-BuffingtonBen Krallop Company

Contractor

FIRST REPORTS

SECTION PLAT

330 Ft. from N. Line

Ft. from S. Line

Ft. from E. Line

330 Ft. from W. Line

		0	

Location _____

Rig up _____

Drilling and Remarks:

clean

RECORD

Cased _____ in., _____ ft.

Sand _____

Gas _____

Oil _____

Total Depth _____

PRODUCTION

1st 24 hrs. Nat. _____

1st 24 hrs. after shot _____

Gas _____ Cu. Ft.

Dry Hole _____

Abandoned _____

Date

11-7-34 19

ORVAL MANNSCHECK

Scout

KANSAS

Map No. 1 Sec. 10 Twp. 35 R. 2EWell No. 1-BuffingtonBen Krallop Company

Contractor

ABANDONED

SECTION PLAT

330 Ft. from N. Line

Ft. from S. Line

Ft. from E. Line

330 Ft. from W. Line

		0	

Location _____

Rig up _____

Drilling and Remarks:

60 + ft

RECORD

Cased _____ in., _____ ft.

Sand Sil 3790

Gas _____

Oil _____

Total Depth 3794

PRODUCTION

1st 24 hrs. Nat. _____

1st 24 hrs. after shot _____

Gas _____ Cu. Ft.

Dry Hole _____

Abandoned _____

Date

7-17-34 192

ORVAL MANNSCHECK

Scout