


Map No. *Summer* **KANSAS** Sec. *10* Twp. *35S* R. *2E*
Well No. *15* *Loggins* Farm
Up River Gas Company

NORTH

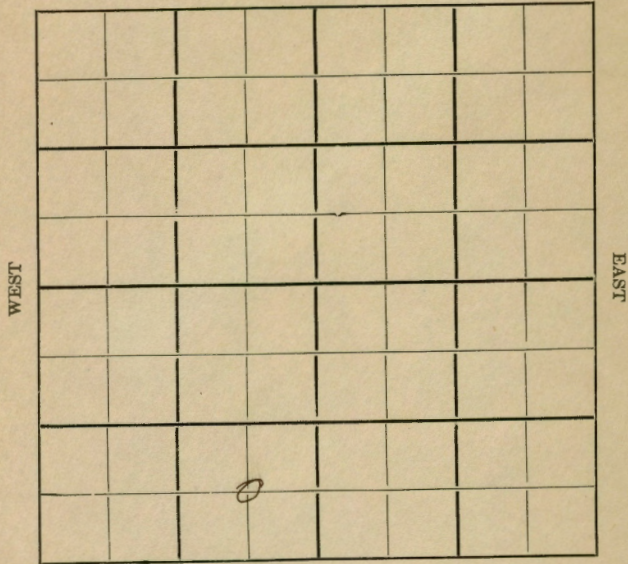

SOUTH

Location.....
Drilling Remarks.....

Rig Up.....
Drilling Remarks.....

RECORD


PRODUCTION

Cased.....in.....ft.
Sand.....
Gas.....
Oil.....
Total Depth.....

1st 24 hrs. Nat.....
1st 24 hrs. after shot.....
Gas.....cu. ft.....
Dry Hole.....
Abandoned.....

Map No.....Sec.....Twp.....R.....
Well No.....Farm
.....Company

NORTH

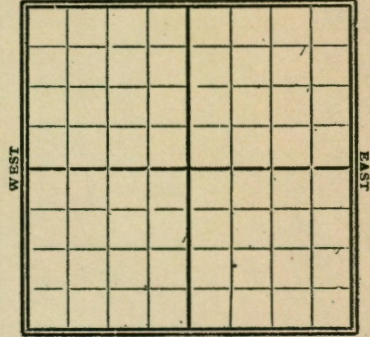

SOUTH

.....Ft. from N. Line
.....Ft. from S. Line
.....Ft. from E. Line
.....Ft. from W. Line

1919
Date

REPORT

Gypsy Records
8/9 *Abd T.D. 1575'*

MAP No. K1 KANSAS SEC. 10 TWP. 35S R. 2E

WELL No. 1 Loggers
Arkansas River Gas COMPANY

CONTRACTOR

SECTION PLAT

ABANDONED

_____ FT. FROM N. LINE

_____ FT. FROM S. LINE

_____ FT. FROM E. LINE

_____ FT. FROM W. LINE

No Record

LOCATION _____

RIG UP _____

DRILLING AND REMARKS

nothing in file

RECORD

CASED _____ IN. _____ FT.

SAND _____

GAS _____

OIL _____

TOTAL DEPTH 1575

PRODUCTION

1ST 24 HRS. NAT. _____

1ST 24 HRS. AFTER SHOT _____

GAS _____ CU. FT.

DRY HOLE ☒

ABANDONED ☒

DATE

8/1 1919 SCOUT