
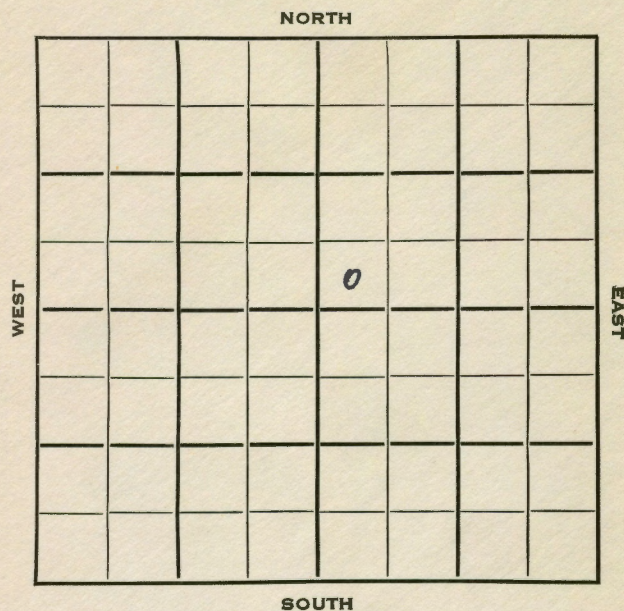


Section 10 Township 35 Range 2 EWell No. # 1 McClaskeyCompany Cappit Drlg.Sec. 10 Twp. 35 R. 2 EWell No. # 1 McClaskey FarmCappit Drlg. CompanyCappit Drlg. Contractor Ft. from N. Line330 Ft. from S. Line Ft. from E. Line330 Ft. from W. Line

SW SW NE

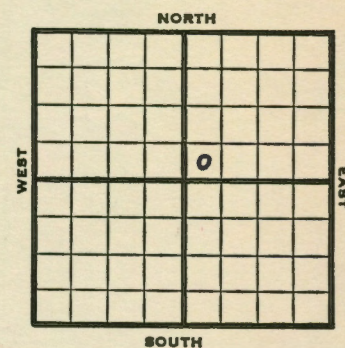

1953

Elev. 1178'

REPORT

6/10

Spud 6-6-53

8" @ 114

Drlg. 160

8/12

Spud 6-6-53

Oil Well

TD 3495

8" @ 114

KC 3002, Bart 3420, Miss 3452

DST 3465-76, opn 2 hrs., rec. 60'

wtr, 1000#

DST 3465-95, opn 1 hr. k rec. 250'

ocm, 1000#

TD 3495

5" @ 3495

CO to 3488

29/3465-70, 1/2 boph

SP 3430, 30/3411-16 SSO

Hydro

CO to 3488 2 bopd

Comp. 25 bopd

COMPLETED

County	Sumner		State	Kansas
Sec.	10 (Blk. Twp.)	35 (Sur. Rge.)	2E	Map No.
Operator	Cappit Drlg.			
Well No.	1	Farm	McClaskey	
Elev.	Location		SW SW NE	

FIRST REPORT

330 Ft. From S Line NE
330 Ft. From W Line Quarter
1st. Report JUN 10 1953
Completion
Remarks
Cappit Drlg. - Contr.
Spudding Date 6-8-53

Drig. Data

8-114 drlg. 160

J. G. McGEHEE

County	Sumner		State	Kansas	
Sec.	10	(Blk. Twp.)	35	(Sur. Rge.)	2E Map No.
Operator	Capitt Drlg.				
Well No.	1	Farm	McClaskey		
Elev.	1178	Location	SW SW NE		

COMPLETE

330 Ft. From	S Line	NE
330 Ft. From	W Line	Quarter
1st. Report		
Completion		AUG 12 1953
Remarks		
Capitt Drlg. - Contr.		
Spudding Date		6-6-53

Drilg. Data Oil well TD 3495

8" @ 114 KC 3002 Bart. 3420
Miss. 3452 DST 3465-76 open 2 hr.
Rec. 60' wtr. 1000# DST 3465-95
open 1 hr. Rec. 250' ocm 1000#
TD 3495 5" @ 3495 CO to 3488
29/ 3465-70 $\frac{1}{2}$ boph SP 3430 30/ 3411-16
SSO Hydro. CO to 3488 2 boph
Comp. 25 bopd

J. G. McGEHEE