


Sumner

KANSAS

Section 1 Township 35 Range 2EWell No. #18 AirportCompany McNeish & Gralapp

NORTH

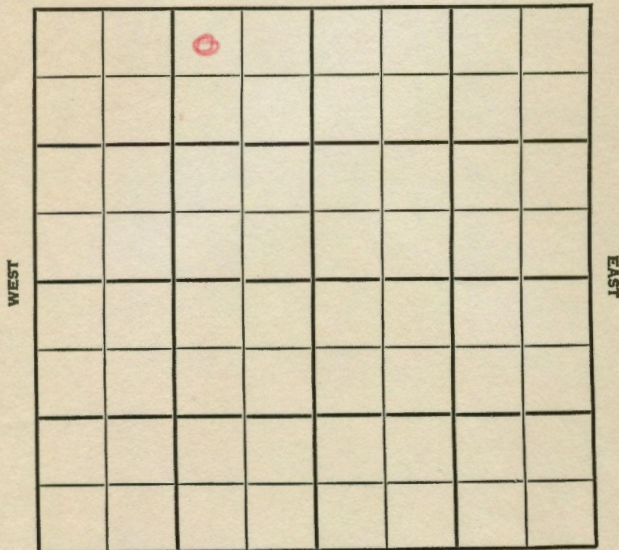

SOUTH

SUMNER			KANSAS		
SEC.	TWP.	R.			
<u>1</u>	<u>35</u>	<u>2E</u>			
WELL NO.					
<u>18 Airport</u>					
FARM					
COMPANY					
<u>McNeish & Gralapp</u>					
CONTRACTOR					
<u>Watson</u>					
<u>Hilltop Pond</u>					


330' Ft. from N. Line

Ft. from S. Line

990' Ft. from E. Line

Ft. from W. Line

NW NE NW

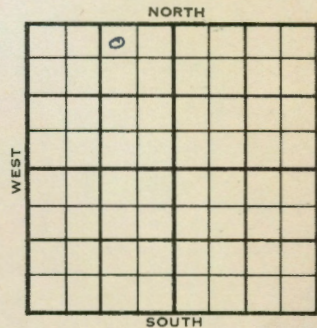

1955

ELEVATION

1212'

REPORT

5/25

Surface Set

ABANDONED

6/1

Abd. Location

County Sumner State Kansas
 Sec. 1 (Blk. 35 (Sur. 2E Map No.
 (Twp.) (Rge.)
 Operator McNeish & Gralapp
 Well No. 18 Farm Airport
 Elev. 1212 Location NW NE NW

0				

330 Ft. From N Line NW
 990 Ft. From E Line Quarter

1st. Report MAY 2 5 1955

Completion

Remarks

Watson - Contr.

Spudding Date

Drig. Data

Hilltop Pool

surface set

FORM 513 REV. SUNRAY

County Sumner Elev. 1212

Sec. 1 Twp. 35 Rge. 2E

Company McNeish & Gralapp

Farm Name Airport No. 18

TOPS	DEPTH	LOG	DATUM	Loc. in Sec.
Anh.				<u>NW NE NW</u>
Tr.				
H.				
Tr.				
Dg.				
Bl.				
L.				
K.C.				Geol.
B.K.C.				Contr.
Ce.				<u>Watson</u>
C.				
M.				
M.				
K.				Pool
Mz.				
Me.				
V.				
S.				
S.				
A.				
R.				
Pf.				
G.				
TD.				

Date Comm. JUN 1 1955

Abd. location

ABANDONED