



Section 1 Township 35 Range 2 E
 Well No. # 1 Barton
 Company H. Bachus & Sons

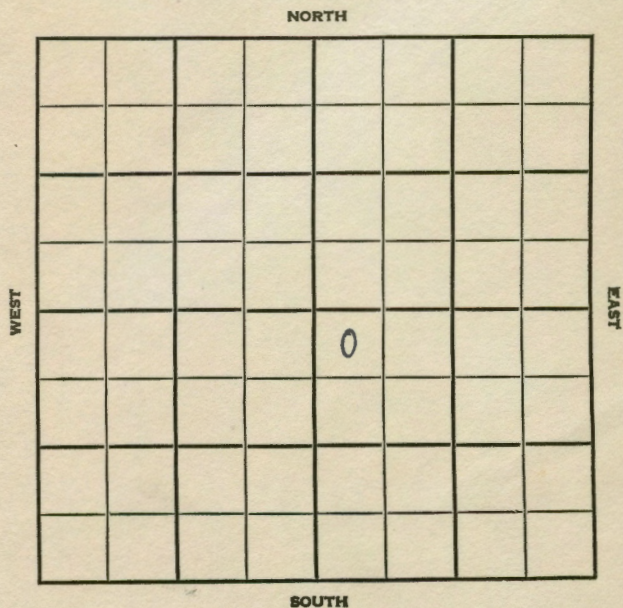

KANSAS
 SEC. 1 TWP. 35 R. 2E
 WELL NO. #1 Barton FARM
 COMPANY H. Bachus & Sons
 CONTRACTOR Smitherman

330 Ft. from N. Line
 _____ Ft. from S. Line
 _____ Ft. from E. Line
330 Ft. from W. Line

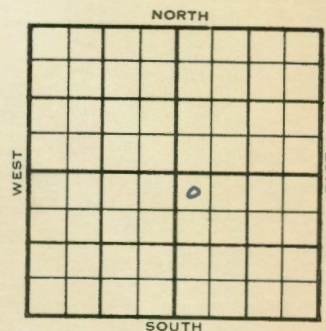

NW NW SE

	ELEVATION	REPORT
1954	1209'	
11/23	Spud 11-18-54 8" @ 90' Drlg. 2690'	
1955 1/5	Spud 11-18-54 Oil well TD 3536 8" @ 90 Bart 3520' DST 3523-36 open 1 hr rec 121 HOCM, 5' free oil, 30' mud & wtr. 900# TD 3536 Hayton 2811 KC 3010 Oswego 3215 B. Oswego 3340' Cong 353 5" @ 3520 frac. P/125 BOPD 20 BW Comp. 25 BOPD 10 BW	

COMPLETED

