



Section 1 Township 35 Range 2 E  
Well No. 2 McLaughlin (*McLaughlin*)  
Company Sinclair

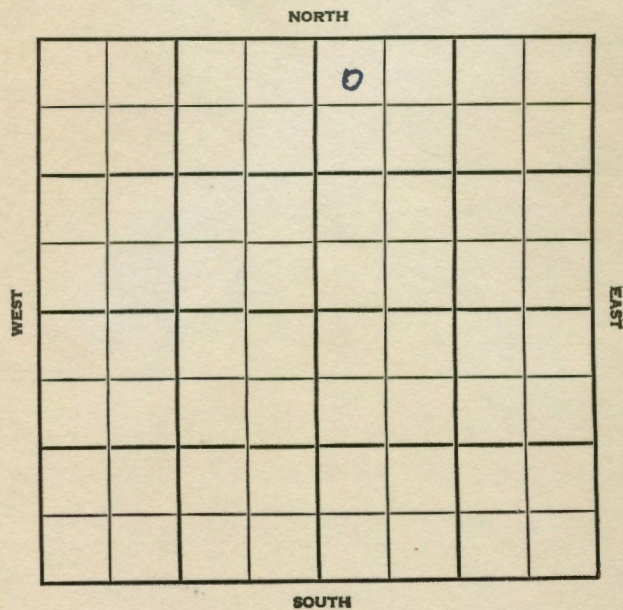

SEC. 1 TWP. 35 R. 2 E  
WELL NO. # 2 McLaughlin FARM  
COMPANY Sinclair  
CONTRACTOR Smitherman  
Hilltop Pool

330 Ft. from N. Line  
Ft. from S. Line  
Ft. from E. Line  
330 Ft. from W. Line

NW NW NE

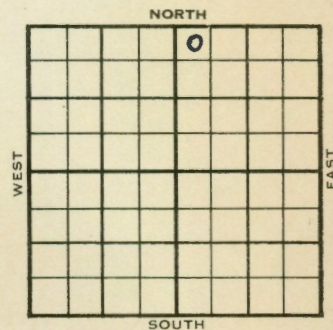

1955

ELEVATION

REPORT

2/16

MIR

|   |          
|---|----------|----------------|-----------------------------|----------|--|--|--|--|--|--|--|--|--|--|--|--|--|--|--|--|--|--|--|--|--|--|--|--|--|--|--|--|------------------------|--|--|
| County   | Summer   |                | State                       | Kansas   |  |  
| Sec.   | 1        | (Blk. Twp.) 35 | (Sur. Rge.) 2E              | Map No.  |  |  
| Operator   | Sinclair |                |                             
| Well No.   | 2        | Farm           | McLaughlin                  |          |  
| Elev.   |          |                | Location                    | NW NW NE |  |  
| <table border="1"><tr><td></td><td></td><td></td><td></td><td></td><td></td></tr><tr><td></td><td></td><td></td><td></td><td></td><td></td></tr><tr><td></td><td></td><td></td><td></td><td></td><td></td></tr><tr><td></td><td></td><td></td><td></td><td></td><td></td></tr><tr><td></td><td></td><td></td><td></td><td></td><td></td></tr></table> |          |                330 Ft. From N Line NE |  |  |
|   |          
|   |          |                | 330 Ft. From W Line Quarter |          |  
|   |          |                | 1st. Report FEB 1 6 1955    |          |  
|   |          |                | Completion                  |          |  
|   |          |                | Remarks                     |          |  
|   |          |                | Smitherman - Contr.         |          |  
|   |          |                | Spudding Date               |          |  
| Drig. Data   |          |                | Hilltop Pool                |          |  
| M I R   |          |                

FABEN GILSTRAP