
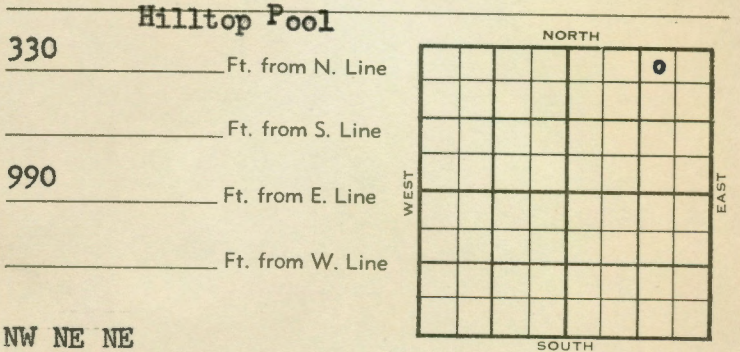


Section 1 Township 35 Range 2E
 Well No. #1 McLaughlin
 Company L. C. Smitherman

SEC.	1	TWP.	35	R.	2E
WELL NO.	1 McLaughlin "B"				
COMPANY	L. C. Smitherman				
CONTRACTOR					

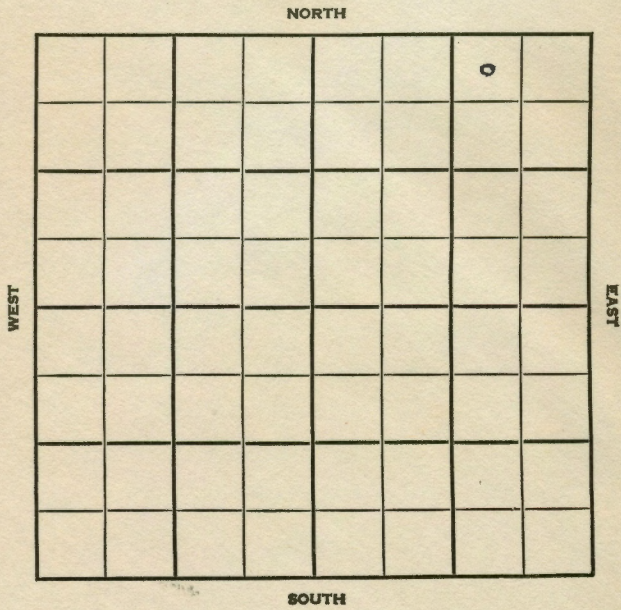

NW NE NE
Sinclair FO

1955	ELEVATION 1210'	REPORT
------	---------------------------	--------

4/6 Location
 4/27 Spud 4-5-55
 Oil well TD 3537 8" @ 117
Stal. 2354' Layton 2796'
Oswego 3188 Bart. 3459' Bart sd 3465
 DST 3465-3537 open 1 hr gas in 4 min
 F/oil in 1 hr 1140# TD 3537
 5" @ 3537 CO 40/3495-3505
 F/50 BOPH 9 hr. F/30 BOPH 6 hr.
 Comp. F/25 BOPD

COMPLETED

County Summer State Kansas
Sec. 1 (Blk. 35 (Sur. 2E (Twp. 2E) Map No.
Operator L. C. Smitherman
Well No. 1 Farm McLaughlin "B"
Elev. 1210 Location NW NE NE

330 Ft. From N Line NE
990 Ft. From E Line Quarter
1st. Report
Completion APR 27 1955
Remarks Hilltop Pool
Spudding Date 4-5-55

Drig. Data Oil well TD 3537
8" @ 117 Stal. 2354 Layton 2796
Oswego 3188 Bart. 3459 Bart. sd. 3465
DST 3465-3537 open 1 hr. gas in 4 min.
F/ oil in 1 hr. 1140# TD 3537
5" @ 3537 CO 40/ 3495-3505
F/ 50 boph 9 hr. F/ 30 boph 6 hr.
Comp. F/ 25 bopd

FABEN GILSTRAP

County Summer State Kansas
Sec. 1 (Blk. 35 (Sur. 2E (Twp. 2E) Map No.
Operator L. C. Smitherman
Well No. 1 Farm McLaughlin
Elev. Location NW NE NE

330 Ft. From N Line NE
990 Ft. From E Line Quarter
1st. Report APR 6 1955
Completion
Remarks Sinclair farmout
Spudding Date

Drig. Data Hilltop Pool
Location

FABEN GILSTRAP