

Summer


KANSAS

SECTION 1 TOWNSHIP 35 RANGE 2 E

WELL NO. #2-A McLaughlin "B"

COMPANY L. C. Smitherman

NORTH

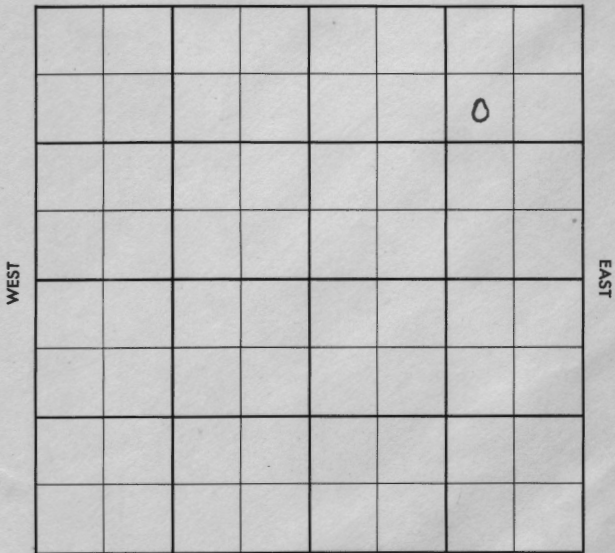

SOUTH

Summer KANSAS

SEC. 1 TWP. 35 R. 2E

WELL NO. #2-A McLaughlin "B" FARM

COMPANY L. C. Smitherman

CONTRACTOR twin well


Hilltop 989 Ft. from N. Line

Ft. from S. Line

990 Ft. from E. Line

Ft. from W. Line

SW NE NE

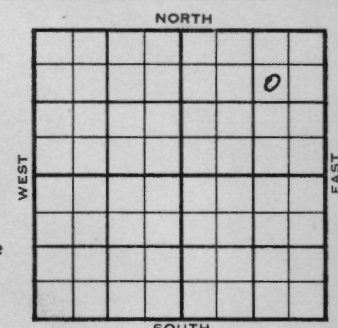

1955 ELEVATION 1208' REPORT

Date	Location	Elevation
10/26	Layton	2798
	KC	2996
	Cleve	3129
	Oswego	3204
	Bart	3494
	Miss	3552
	5" @ 3553	
11/9	5" @ 3553	
	Layton	2798
	KC	2996
	Cleve	3129
	Oswego	3204
	Barb	3494
	Miss	3552
	TD	3553
64/3492-3508 F/42 boph		
Comp F/25 bopd		

COMPLETED

DX-78

O.W.W.O.

FORM 513 SUNRAY

County Sumner Elev. _____
 Sec. 1 Twp. 35 Rge. 2E
 Company Midwest Oil Corp.
 Farm Name McLaughlin No. 2

TOPS	DEPTH	LOG	DATUM	Loc. in Sec.
Anb.				SW NE NE
Tr.				<u>O.W.W.O.</u>
H.				
Dg.				
Bl.				
L.				Geol. _____
K.C.				Contr. _____
B.K.C.				
Ce.				
C.				
M.				
M.				Pool
K.				<u>Hilltop</u>
Mz.				
Me.				
V.				
S.				
S.				
A.				
R.				
Pe.				
G.				
T.D.				

ABANDONED
 FIRST REPORT
 OCT 31 '56

Date Comm. OTD 3553 PB 2723 60/ 2385-2415
Input 33 bwph

Co.
 No.
 Sec.
 T.
 R.

County Summer Elev. 1208
 Sec. 1 Twp. 35 Rge. 2E
 Company L. C. Smitherman
 FarmName McLaughlin "B" No. 2-A

County Summer Elev. 1208
 Sec. 1 Twp. 35 Rge. 2E
 Company L. C. Smitherman
 FarmName McLaughlin "B" No. 2-A

TOPS	DEPTH	LOG	DATUM	Loc. in Sec.
Anh.				SW NE NE
Tr.				989' NL
Dg.				990' EL
Bl.				twin well
L. <u>Layton</u>	<u>2798</u>			Geol.
K.C.	<u>2996</u>			Contr.
B.K.C. <u>Cleve.</u>	<u>3129</u>			
Ce. <u>Oswego</u>	<u>3204</u>			
C.				Pool
M. <u>Bark</u>	<u>3494</u>			Hilltop
M. <u>Miss</u>	<u>3552</u>			
K.				
Mz.				
Me.				
V.				
S.				
S.				
A.				
R.				
PE.				
G.				
T.D.	<u>3553</u>			

TOPS	DEPTH	LOG	DATUM	Loc. in Sec.
Anh.				SW NE NE
Tr.				989' NL
Dg.				990' EL
Bl.				
L. <u>Layton</u>	<u>2798</u>		<u>4006</u>	Geol.
K.C.	<u>2996</u>		<u>4788</u>	Contr.
B.K.C. <u>Cleve.</u>	<u>3129</u>		<u>1921</u>	
Ce. <u>Oswego</u>	<u>3204</u>		<u>1976</u>	
C.				Pool
M. <u>Bark</u>	<u>3494</u>		<u>2286</u>	Hilltop
M. <u>Miss</u>	<u>3552</u>		<u>2344</u>	
K.				
Mz.				
Me.				
V.				
S.				
S.				
A.				
R.				
PE.				
G.				
T.D.	<u>3553</u>			

FIRST REPORT
 OCT 25 '55

COMPLETE

Date Comm. 5" @ 3553

Date Comm. NOV 9 1955
5" @ 3553 6h/ 3492-3508 F/ 42 boph
Comp. F/ 25 bopd