


Section 1 Township 35 Range 2 E

Well No. #1, McLaughlin "B"

Company L. C. Smitherman

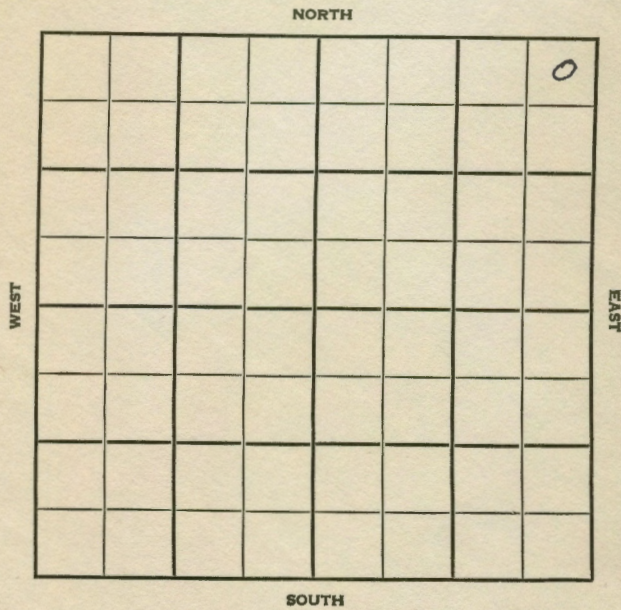

Summer

SEC. 1	TWP. 35	R. 2E
--------	---------	-------

WELL NO. #1 McLaughlin "B" FARM

COMPANY L. C. Smitherman

CONTRACTOR Co. Tools Hilltop

200' _____ Ft. from N. Line

_____ Ft. from S. Line

_____ Ft. from E. Line

_____ Ft. from W. Line

NE NE NE

	ELEVATION	REPORT
1955	1215'	
8/24	R U R	
9-21	Comm. 8-23-55 8 5/8" @ 120 w/150; 5 1/2" 3536 w/85 40/3488-98; 20/3503-08; flo 35 boph nat flo 25 bopd no wtr.	
	Tops:	Depth Log
	La6	2802 2802
	K.C.	2978 2978
	Big Ls.	3182 3189
	Barts.	3478
	T.D.	3536'

COMPLETED

County **Sumner** Elev. **1215**
 Sec. **1** Twp. **35S** Rge. **2E**
 Company **L. C. Smitherman**
 Farm Name **McLaughlin "B"** No. **4**

TOPS	DEPTH	LOG	DATUM	Loc. in Sec.
Lay	2802	2802	1587	NE NE NE 200' NL
		2978	1763	Geol.
Big Is.		3189	1974	Cantr.
Barts.		3478	2263	Co. tools
				Pool
				Hilltop
				COMPLETE
	3536			

Date Comm. **8-23-55** SEP 2 1 1955
8-5/8" 120 w/150; 5 1/2" 3536 w/85;
40/3488-98; 20/3503-08; flo 35 boph nat.
flo 25 bopd no wtr.

County **Sumner** Elev. _____
 Sec. **1** Twp. **35** Rge. **2E**
 Company **L. C. Smitherman**
 Farm Name **McLaughlin "B"** No. **4**

TOPS	DEPTH	LOG	DATUM	Loc. in Sec.
				NE NE NE 200' NL
				Geol.
				Cantr.
				Co. tools
				Pool
				Hilltop
				COMPLETE

Date Comm. _____
RUR

ANG 22 1955
FIRST REPORT