


O.W.W.O.

Sumner

KANSAS

Section 1 Township 35 Range 2 E
 Well No. # 1 Dean
 Company L. C. Smitherman

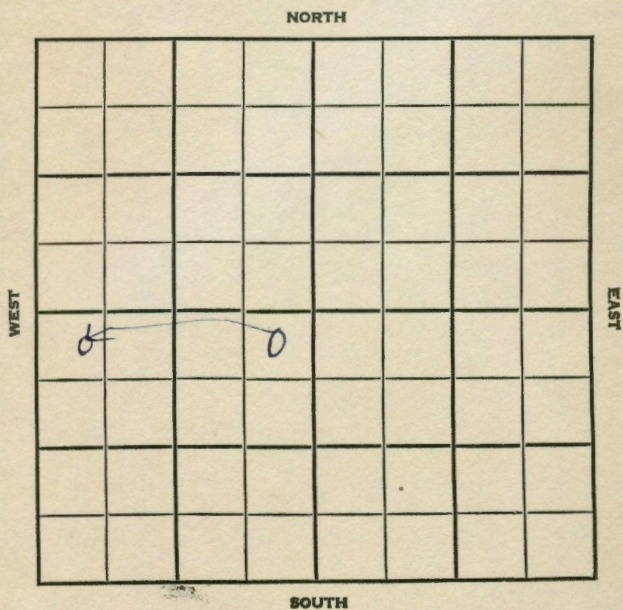

O.W.W.O. Sumner KANSAS
 SEC. 1 TWP. 35 R. 2E

WELL NO.

#1 Dean

FARM

COMPANY

L. C. Smitherman

CONTRACTOR

330

Ft. from N. Line

Ft. from S. Line


330

Ft. from E. Line

330

Ft. from W. Line

NW NW
 NE NE-SW

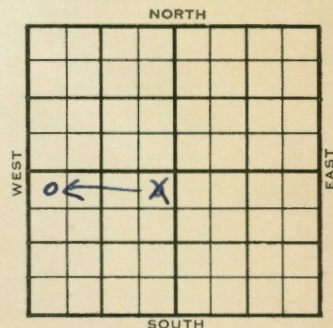

1955

ELEVATION

1207'

REPORT

1/5

Setting Surface.

5/25

8" @ 100

DST 3512-38 open 1 hr rec 300' GCM
& SW 1120/20" D & A

Tops: Stal. 2364', Lay 2803',

Kans. City 2998', Osw 3202', Bart. 348

Bart sd 3512'

TD 3538' - D & A

ABANDONED

1956

O.W.W.O.

7-18

Comm. 7-14-56

OTD 3538

CO to 3543

5" @ 3543

Stal. 2364'; Lay. 2803'; KC. 2998';

Oswego 3202'; Bart. 3483'; Bart.sd

3572';

COMPLETED

O.W.W.O.

County	Sumner	Elev.	
Sec.	1	Twp.	35
Company	L. C. Smitherman	Rge.	2E
Farm Name	Dean	No.	1

TOPS	DEPTH	LOG	DATUM
Anh.			
Tp.	Stal.	2364	
H.			
Tr.	Layton	2803	
Dg.			
Bl.			
L.		2998	
K.C.			
B.K.C.			
C.	Oswego	3202	
M.	Bart.	3483	
K.	Bart. sd.	3572	
Mz.			
Mo.			
V.			
S.			
S.			
A.			
R.			
Pe.			
G.			

Date Comm. 7-14-56 JUL 18 '56
 OTD 3538 CO to 3543 5" @ 3543

29

R.G.

County	Sumner	State	Kansas
Sec.	1	(Blk.) 35 (Sur.) 2E	Map No.
Operator	L. C. Smitherman		
Well No.	1	Farm	Dean
Elev.		Location	NE NE SW

FIRST REPORT	
--------------	--

330 Ft. From N Line SW

330 Ft. From E Line Quarter

1st. Report JAN 5 1955

Completion

Remarks

Spudding Date

Drig. Data

setting surface

FABEN GILSTRAP

FORM 513 SUNRAY

County Sumner Elev. 1207 DF
 Sec. 1 Twp. 35 Rge. 2E
 Company L. C. Smitherman
 Farm Name Dean No. 1

TOPS	DEPTH	LOG	DATUM	Loc. in Sec.
Anh.				
TP. <u>Stal.</u>	<u>2364</u>			<u>NW NW SW</u>
H.				<u>CMO</u>
Tr. <u>Layton</u>	<u>2803</u>			
Dg.				
Bl.				
L.	<u>2998</u>			Geol.
K.C.				Contr.
B.K.C.				See-Pos-See
Ce. <u>Oswego</u>	<u>3202</u>			
C.				Pool
M. <u>Bart.</u>	<u>3512</u>			<u>Murphy</u>
M.				
Mz.				
Me.				
V.				
S.				
S.				
A.				
R.				
Pe.				
G.				
TD.	<u>3538</u>			<u>COMPLETE</u>

Date Comm. 7-11-56
OTD 3538 CO to 3543 5" @ 3543 JUL 25 '56
WOCT AUG 1 '56 CO 48/3515-21
FRAC AUG 8 '56 & LD. AUG 15 '56 AUG 22 '56
✓ AUG 29 '56 ✓ SEP 5 '56 SEP 12 '56 P.
25 Bopd + 12 Bwopd.

ABANDONED

FORM 513 REV. SUNRAY

County Sumner Elev. 1207
 Sec. 1 Twp. 35 Rge. 2E
 Company L. C. Smitherman
 Farm Name Dean No. 1

TOPS	DEPTH	DATUM	Loc. in Section
Cim. Anhydrite			<u>NW NW SW</u>
Ft. Riley			<u>Correct Spot</u>
Howard <u>Stal.</u>	<u>2364</u>	<u>1157</u>	<u>from NE NE SW</u>
Topeka <u>Lay</u>	<u>2803</u>	<u>1596</u>	<u>Drig. Contr. to above.</u>
Heebner Sh.			
Toronto Ls.			
Brown Lime			
Lansing	<u>2998</u>	<u>1791</u>	Pool
Kans. City			
B. K. C. <u>Osw.</u>	<u>3202</u>	<u>1995</u>	
Congl. <u>Bart.</u>	<u>3483</u>	<u>2276</u>	
Miss. <u>Bart. sd.</u>	<u>3512</u>	<u>2305</u>	
Kinderhook			
Misener			
Hunton			
Sylv. Maquo			
Viola			
Simpson			
Smp.			
Gorham			
Arbuckle			
Basal Sand			
Pre. Cam.			
T. D.	<u>3538</u>		

8" @ 100 DST 3512-38 open 1 hr.

Rec. 300' gcm & sw 1120/20"

D & A

Date Comm.

Date Comp. MAY 25 '55