


Section 13 Township 35 Range 2E

Well No. 1 Jones

Company Carl Hines

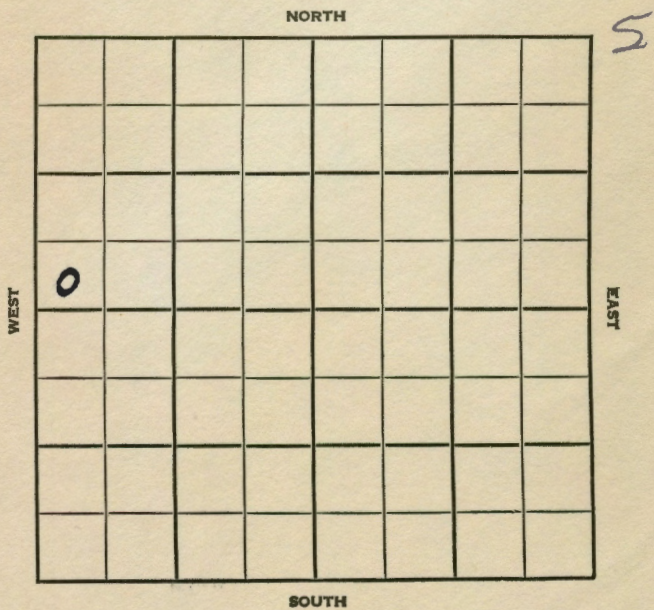

SEC. 13 TWP. 35 R. 2E

WELL NO. 1 Jones FARM

COMPANY Carl Hines

CONTRACTOR Smitherman
SW Murphy Pool


_____ Ft. from N. Line

330

_____ Ft. from S. Line

_____ Ft. from E. Line

330 _____ Ft. from W. Line

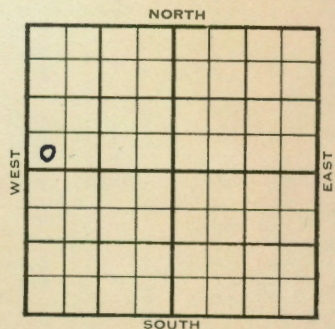

SW SW NW

1954	ELEVATION	REPORT
	<u>1205'</u>	

7/28 Spdg 7-24-54
8" @ 151
Drlg. 1316

11/3 Spud 7-24-54 - Oil Well
TD 3165'
8" @ 151'
Stal. 2378', Layton 2822', KC 3053',
Checkerboard 3113', Cleve 3150'
TD 3165'
5" @ 3149'
CO to 3165' frac
3 to 4 mcfg
F/62 bo
Comp. 25 bopd 1,000,000 cfgpd

COMPLETED

