

Section 13 Township 35 Range 2 E

Well No. #4 Jones

Company Carl Hines

SEC. <u>13</u>	TWP. <u>35</u>	R. <u>2E</u>
----------------	----------------	--------------

WELL NO. #4 Jones FARM

COMPANY Carl Hines

CONTRACTOR Martin

State Line


_____ Ft. from N. Line

_____ Ft. from S. Line

_____ Ft. from E. Line


_____ Ft. from W. Line

SE NW NW

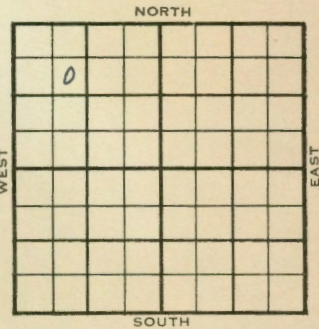

NORTH

4

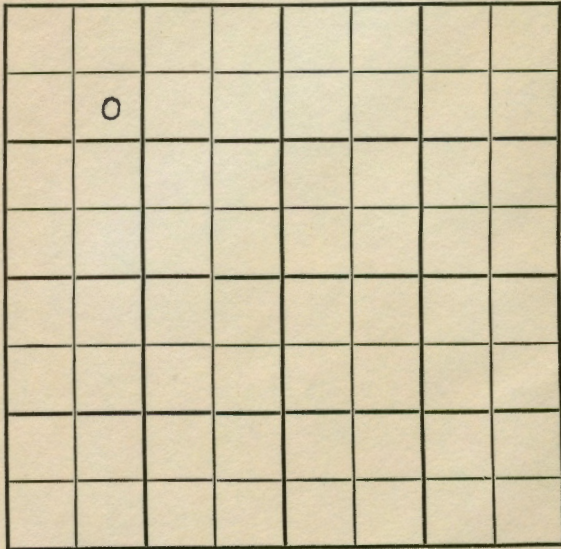

SOUTH

1955	ELEVATION	REPORT
9-14	Comm. 9-3-55 8" @ 160 5" @ 3569 TD 3570'	
10/19	Comm 9-3-55 8" @ 160 5" @ 3569 Stal 2385 Layton 2835 Cleve 3144 Oswego 3226 Bart 3528 M 3566 TD 3190 3570 PB 3190 80/3144-64 frac 7,100 mcfgpd 30 bo Comp 7,100 mcfgpd 30 bo	

COMPLETED

County Sumner Elev. _____
 Sec. 13 Twp. 35 Rge. 2E
 Company Carl Hines
 FarmName Jones No. 4

TOPS	DEPTH	LOG	DATUM	Loc. in Sec.
Anh.				SE NW NW
T.P. <u>Stat</u>	<u>2385</u>			
H. <u>Fantam</u>	<u>2835</u>			
Tr. <u>Alsh.</u>	<u>3144</u>			
Dg. <u>Comp.</u>	<u>3226</u>			
Bl. <u>East</u>	<u>3528</u>			
L.				Geol.
K.C.				Contr
B.K.C.				<u>Martin</u>
Ce.				Pool
C.	<u>3566</u>			<u>State Line</u>
M.				
K.				
Mz.				
Me.				
V.				
S.				
S.				
A.				
R.				
Pe.				
G.				
TD.	<u>3570</u>			

Date Comm. 9-3-55 OCT 19 1955
8" @ 160 5" @ 3569 TD 3570
PB 3190 80/ 3144-64 frac
7,100 mcfgpd 30 bo
Comp. 7,100 mcfgpd 30 bo

COMPLETE

County Sumner Elev. _____
 Sec. 13 Twp. 35 Rge. 2E
 Company Carl Hines
 FarmName Jones No. 4

TOPS	DEPTH	LOG	DATUM	Loc. in Sec.
Anh.				SE NW NW
T.P.				
H.				
Tr.				
Dg.				
Bl.				
L.				Geol.
K.C.				Contr
B.K.C.				<u>Martin</u>
Ce.				Pool
C.				<u>State Line</u>
M.				
M.				
K.				
Mz.				
Me.				
V.				
S.				
S.				
A.				
R.				
Pe.				
G.				
TD.				

Date Comm. 9-3-55
8" @ 160 5" @ 3569 TD 3570

SEP 14 55
 FIRST REPORT