

KANSAS

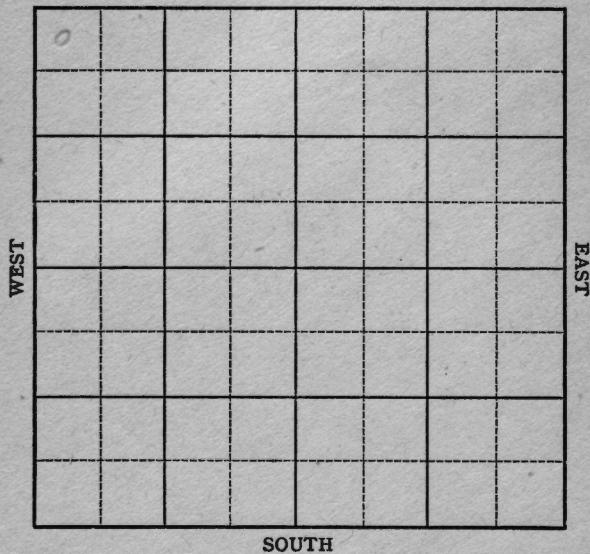
Sumner County

FORM 51 IOM 12-46 PETROL

Section 14 Township 35 Range 2-EWell No. 1 McCordory (*McCorgary*)Company McNish & Gralapp et al

Miscellaneous

NORTH

DRM 252-A
SM 12-46 PETROLSummer ✓Sec. 14 Twp. 35 R. 2-EWell No. #1 McCordory FarmCompany McNish & Gralapp et al.

Miscellaneous

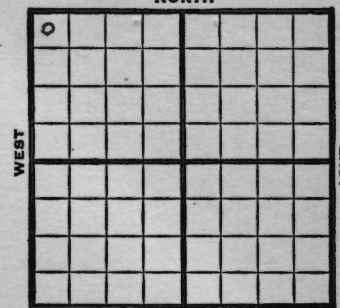
330 Ft. from N. Line

Ft. from S. Line

Ft. from E. Line

330 Ft. from W. Line

NORTH



SOUTH

NW/C

1947 Elev. 1179: REPORT

7/9 Surface hole

7/16 8" @ 96'
Drlg 615'

7/22 Drlg. 2155'

7/29 SD

8/6 Bart 3430'
TD 3498'
5" @ 3431'

8/13 "

8/20 BP 2795'
30 shots 2750-75'

8/27 "

9/3 "

9/10 "

9/17 "

OVER

1947

9/24 Bart. 3430'
5" @ 3431'
Flow 10 oil Pot
2 M Gas
39.0 Gr.
TD 3498'

COMPLETED

Map No. 1 Sec. 14 Twp. 35 R. 2EWell No. 1 McCordoryMcNish & Gralapp et al. Company

COMPLETE

Contractor

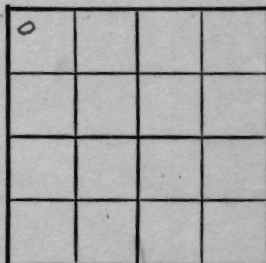
NW/C

SECTION PLAT

330 Ft. from N. Line

Ft. from S. Line

Ft. from E. Line

330 Ft. from W. Line

Sumner County

Location

Rig up

Drilling and Remarks:

Bait 34305' 10 3430Flow 10 oil2 M Gas39-34

Date

SEP 24 1947 19 S. J. LEWIS Scout

RECORD

Cased in, ft.

Sand

Gas

Oil

Total Depth 3495

PRODUCTION

1st 24 hrs. Nat.

1st 24 hrs. after shot

Gas Cu. Ft.

Dry Hole

Abandoned

Map No. Sec. 14 Twp. 35 R. 2EWell No. 1 McCordoryMcNish & Gralapp et al. Company

FIRST REPORT

Contractor

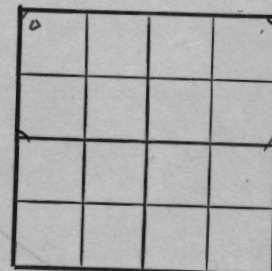
NW/C

SECTION PLAT

330 Ft. from N. Line

Ft. from S. Line

Ft. from E. Line

330 Ft. from W. Line

Sumner County

Location

Rig up

Drilling and Remarks:

surface hole

RECORD

Cased in, ft.

Sand

Gas

Oil

Total Depth

PRODUCTION

1st 24 hrs. Nat.

1st 24 hrs. after shot

Gas Cu. Ft.

Dry Hole

Abandoned

Date

JUL 9 1947 19 S. J. LEWIS Scout