

Sumner **KANSAS**

Section 14 Township 35 Range 2E

Well No. 2 McCorgary

Company L. C. Smitherman

Sumner **KANSAS**

SEC. 14 TWP. 35 R. 2 E ✓

WELL NO. # 2 McCorgary FARM

COMPANY L. C. Smitherman

CONTRACTOR Smitherman

State Line Pool



_____ Ft. from N. Line

330 _____ Ft. from S. Line

990 _____ Ft. from E. Line

_____ Ft. from W. Line

SW SE SE

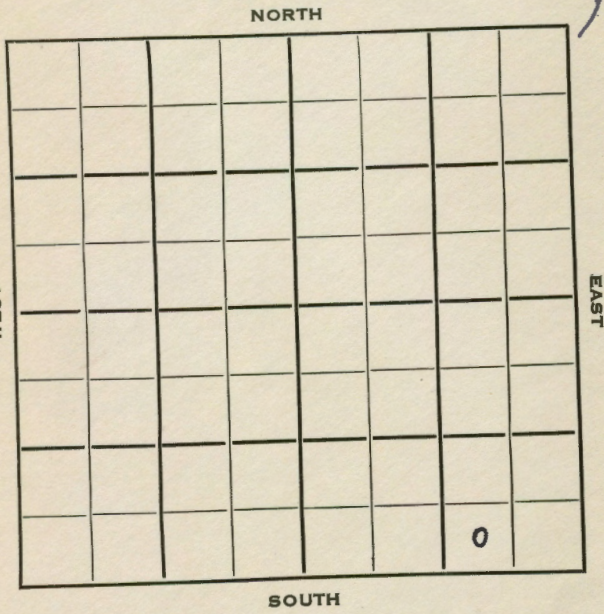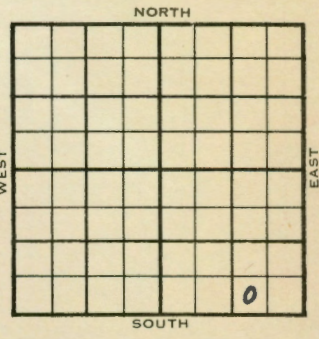

	ELEVATION	REPORT
1953	1192'	
11/4	Spud 10-29-53 8" @ 100 Drlg. 2610'	
1954 2/10	Spud 10-29-53 Oil Well TD 3169' 8" @ 100' Cleveland 3158' TD 3159' 5" @ 3158' DD 3169' Hydro. F/190 bo 28 hrs. Layton 2843', Checkerboard 3066', Peru sd 3157' P/50 bopd Sd-frac F/350 bopd 2 bw Comp.	

COMPLETED

County Sumner State Kansas
 Sec. 14 (Blk. 35 (Sur. 2E Map No.
 Operator L. C. Smitherman
 Well No. 2 Farm McCorgary
 Elev. 1192 Location SW SE SE

330 Ft. From S Line SE
 990 Ft. From E Line Quarter
 Ist. Report
 Completion FEB 10 1954
 Remarks State Line Pool
Smitherman - Contr.
 Spudding Date 10-29-53

Drig. Data Oil well TD 3169
8" @ 100 Cleveland 3158 TD 3159
5" @ 3158 DD 3169 Hydro. F/ 190 bo
28 hr. Layton 2843 Checkerboard 3066
Peru sd. 3157 P/ 50 bopd sd-frac
F/ 350 bopd. 2 bw Comp.

J. G. McGEHEE

County Sumner State Kansas
 Sec. 14 (Blk. 35 (Sur. 2E Map No.
 Operator L. C. Smitherman
 Well No. 2 Farm McCorgary
 Elev. 1192 Location SW SE SE

330 Ft. From S Line SE
 990 Ft. From E Line Quarter
 Ist. Report NOV 4 1953
 Completion
 Remarks
Smitherman - Contr.
 Spudding Date 10-29-53

Drig. Data State Line Pool
8" @ 100 drlg. 2610

J. G. McGEHEE