



Section 14 Township 35 Range 2E  
Well No. 1 McCorgary "A"  
Company L. C. Smitherman

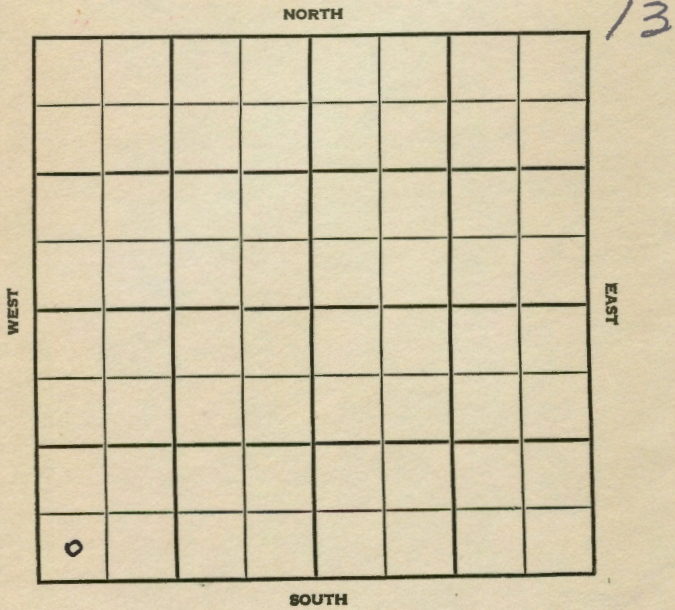

SEC. 14 TWP. 35 R. 2E ✓  
 WELL NO. 1 McCorgary "A" FARM  
 COMPANY L. C. Smitherman  
 CONTRACTOR Smitherman

State Line Pool  
 \_\_\_\_\_ Ft. from N. Line  
330 \_\_\_\_\_ Ft. from S. Line  
 \_\_\_\_\_ Ft. from E. Line  
330 \_\_\_\_\_ Ft. from W. Line

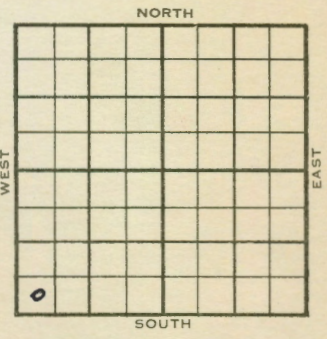

SW S<sup>W</sup> SW  
 1954 ELEVATION 1192 REPORT

6/9 Loc.  
 12/7 Oil well  
 TD 3532  
 Stal 2396 Layton 2826 Peru 3152  
 Bart. 3527  
 DST 3526-32 open 1 hr. Rec. 30' sgsm  
 1060#  
 TD 3532  
 5" @ 3526 72/ 3149-55 frac F/ 90 bop  
 8 hr. Comp. 26 bopd

**COMPLETED**

