


Section 14 Township 35 Range 2 E

Well No. #6 McCorgory "A"

Company L. C. Smitherman

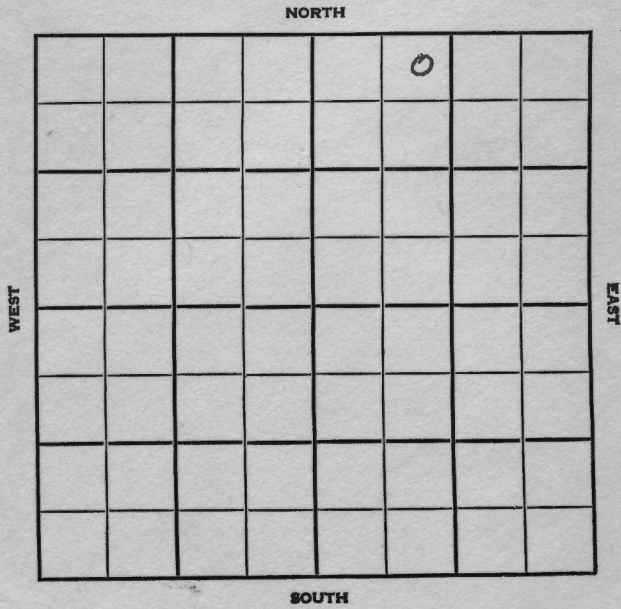

SEC. 14 TWP. 35 R. 2E

WELL NO. #6 McCorgory "A" FARM

COMPANY L. C. Smitherman

CONTRACTOR Co. Tools


N. Vernon

_____ Ft. from N. Line

_____ Ft. from S. Line

_____ Ft. from E. Line

_____ Ft. from W. Line

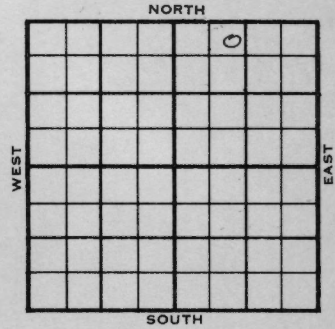

NE NW NE

	ELEVATION	REPORT
1956	1211	
2-29	Comm. 2-25-56 8" @ 150/85 Drlg. 600	
3/28	Comm 2-25-56 8" @ 150/85 DST 3486-3515 open 1 hr gas to surface in 45 min. rec 70' free oil 65' hocm 1030/20" 5 1/2" @ 3514 CO to 3514 24/3506- 14 frac F/28 boph 20 hr Comp 25 bopd	

COMPLETED

County Summer Elev. _____
 Sec. 14 Twp. 35 Rge. 2E
 Company L. C. Smitherman
 FarmName McCorgory "A" No. 6

TOPS	DEPTH	LOG	DATUM	Loc. in Sec.
Anh.				NE NW NE
Tp.				
H.				
Tr.				
Dg.				
Bl.				
L.				
K.C.				Geol. _____
B.K.C.				Contr. _____
Ce.				Co. tools
C.				
M.				Pool _____
M.				N. Vernon
K.				
Mz.				
Ma.				
V.				
S.				
S.				
A.				
R.				
Pe.				
G.				
T.D.				

Date Comm. 2-25-56
8" @ 150/85 drlg. 600

FIRST REPORT
 FEB 29 '56

County Summer Elev. 1211
 Sec. 14 Twp. 35 Rge. 2E
 Company L. C. Smitherman
 FarmName McCorgory "A" No. 6

TOPS	DEPTH	LOG	DATUM	Loc. in Sec.
Anh.				NE NW NE
Tp.				
H.				
Tr.				
Dg.	<u>BT 1</u>	<u>3486</u>	<u>2275</u>	
Bl.				
L.				
K.C.				Geol. _____
B.K.C.				Contr. _____
Ce.				Co. tools
C.				
M.				Pool _____
M.				N. Vernon
K.				
Mz.				
Ma.				
V.				
S.				
S.				
A.				
R.				
Pe.				
G.				
T.D.	<u>3515</u>			

Date Comm. 2-25-56
8" @ 150/85 DST 3486-3515 open 1 hr.

gas to surface in 45 min. rec. 70' free
 oil 65' hocm 1030/20" 5 1/2" @ 3514
 CO to 3514 24/ 3506-14 frac
 F/ 28 boph 20 hr. Comp. 25 bopd

COMPLETE
 MAR 28 '56