

KANSAS

Summer

FORM 252-A
5M 9-42 GASS


KANSAS

Cowley Summer


FORM 51 5M 1-42 PETROL

Section 14 Township 35 Range 2-E
Well No. #1 Union Central Life
Company Alco Valve

Sec. 14 Twp. 35 R. 2-E
Well No. #1 Union Central Life Farm
Alco Valve Company

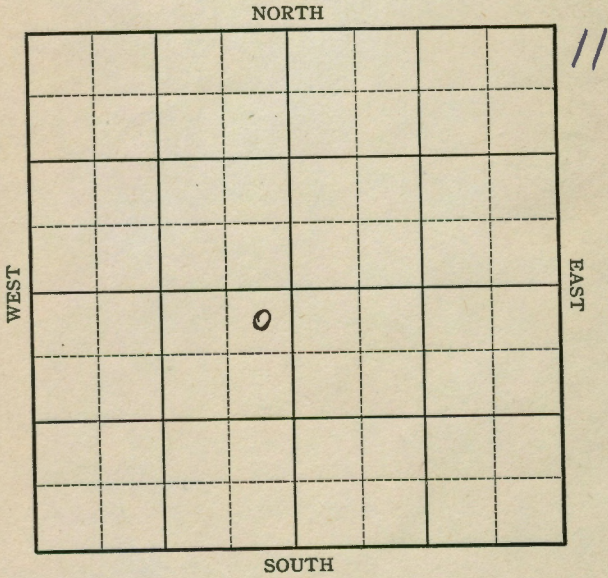

330 Ft. from N. Line
Ft. from S. Line
330 Ft. from E. Line
Ft. from W. Line
Elev. 1208

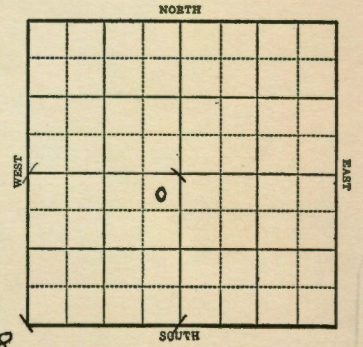

1943 REPORT

5/19	Location
5/26	"
6/2	Rotary
6/9	Surface hole
6/16	8" @ 110 Drlg. 1120'
6/23	Drlg. 2050'
6/30	Hayton 2832 Drlg. 2870'
7/7	Miss 3537 T. D. 3556 SD
7/15	" " "
7/21	Simp. 3825 T.D. 3844'

ABANDONED

Cowley

KANSAS
Map No. 1 Sec. 14 Twp. 35 R. 2E

Well No. 1 Union Central Life

Alco Valve Company

FIRST REPORT Contractor

NE SW


SECTION PLAT

330 Ft. from N. Line

_____ Ft. from S. Line

330 Ft. from E. Line

_____ Ft. from W. Line

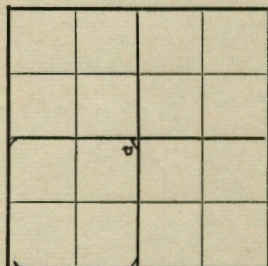

MISCELLANEOUS

Location XXX

Rig up _____

Drilling and Remarks:

RECORD

Cased _____ in., _____ ft.

Sand _____

Gas _____

Oil _____

Total Depth _____

PRODUCTION

1st 24 hrs. Nat. _____

1st 24 hrs. after shot _____

Gas _____ Cu. Ft.

Dry Hole _____

Abandoned _____

Date

MAY 19 1943 19

S. J. LEWIS Scout

Sumner

KANSAS
Map No. 1 Sec. 14 Twp. 35 R. 2E

Well No. 1 Union Central Life

Alco Valve Company

ABANDONED Contractor

NE SW


SECTION PLAT

330 Ft. from N. Line

_____ Ft. from S. Line

330 Ft. from E. Line

_____ Ft. from W. Line

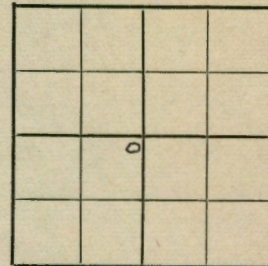

MISCELLANEOUS

Location _____

Rig up _____

Drilling and Remarks:

Temp 3825

RECORD

Cased _____ in., _____ ft.

Sand _____

Gas _____

Oil _____

Total Depth 3844

PRODUCTION

1st 24 hrs. Nat. _____

1st 24 hrs. after shot _____

Gas _____ Cu. Ft.

Dry Hole _____

Abandoned _____

Date

JUL 21 1943 19

S. J. LEWIS Scout

KANSAS

Sumner

Map No. / Sec. 14 Twp. 35 R. 2E

Well No. 1 Union Central Life

Alco Valve Company

CORRECTION Contractor

NE SW

330 Ft. from N. Line

_____ Ft. from S. Line

330 Ft. from E. Line

_____ Ft. from W. Line

SECTION PLAT

MISCELLANEOUS

Location _____

Rig up _____

Drilling and Remarks:

Reported in

Cowley

RECORD

Cased _____ in., _____ ft.

Sand _____

Gas _____

Oil _____

Total Depth _____

PRODUCTION

1st 24 hrs. Nat. _____

1st 24 hrs. after shot _____

Gas _____ Cu. Ft.

Dry Hole _____

Abandoned _____

Date

MAY 22 1943 19

S. J. LEWIS Scout