


Section 15 Township 35 Range 2-E

Well Number 2 Herrick

Company Sinclair-Prairie

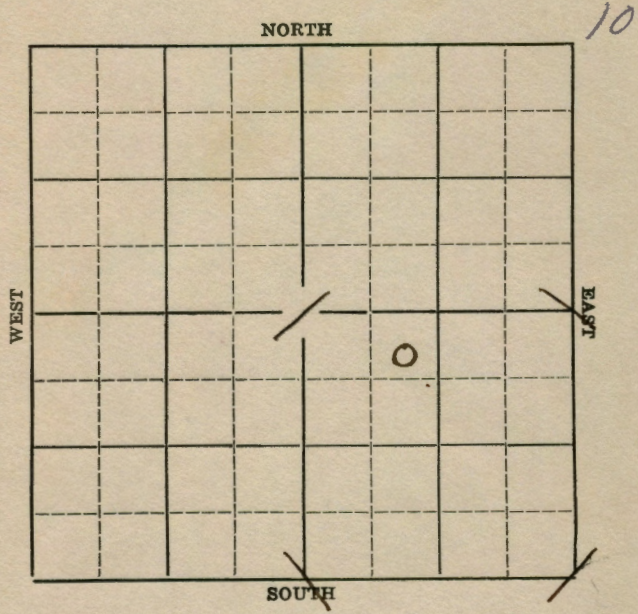


Sec. 15 Twp. 35 R. 2-E

Well No. #2 Herrick Farm

Sinclair-Prairie. Company

_____ Ft. from N. Line
2290 Ft. from S. Line
 _____ Ft. from E. Line
990 Ft. from W. Line

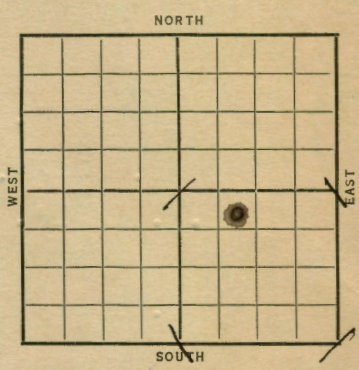

Date	REPORT
1937	
2/24	Rig
3/4	"
3/11	Drlg. 185'
3/18	15" @ 725' Drlg.
3/25	12" @ 1310' Drlg.
4/2	Drlg. 1920'.
4/8	Drlg. 2035'
4/16	Drlg. 2478'.
4/23	8" @ 2432'. Drlg. 2662'.
4/30	Drlg. 3100'.
5/7	8" @ 2435'. Bart. 3372'.
	6" @ 3372'. C.O.
5/14	T.D. 3432'. Est. 2 M Cu. ft. gas & 100 bbl. oil.
5/21	" " " "
5/28	" " " "
6/4	" " " "

OVER

1937

6/9 6" @ 3372'.

Bart. 3372'.

T.D. 3431'.

Shot W/30 qts. 3416-31'.

Pot. 170 bbls.

COMPLETED

Summer **KANSAS**

Map No. 1 Sec. 15 Twp. 35 R. 2E

Well No. 2-Herrick

Sinclair Prairie Company
Contractor

COMPLETED

SECTION PLAT

~~35~~ Ft. from N. Line
2290 Ft. from S. Line
Ft. from E. Line
990 Ft. from W. Line

		0	

Location _____

Rig up _____
Drilling and Remarks:

Shot w/30gts
3416-38
pat - 170

RECORD

Cased 6 in., 3372 ft.
Sand BART 3372
Gas _____
Oil _____
Total Depth 3431

PRODUCTION

1st 24 hrs. Nat. _____
1st 24 hrs. after shot _____
Gas _____ Cu. Ft.
Dry Hole _____
Abandoned _____

Date

JUN 9 1937 19 H. D. Hatfield Scout

Summer **KANSAS**

Map No. 1 Sec. 15 Twp. 35 R. 2E

Well No. 2-Herrick

Sinclair-Prairie Company
Contractor

SECTION PLAT

_____ Ft. from N. Line
2290 Ft. from S. Line
_____ Ft. from E. Line
990 Ft. from W. Line

		0	

FIRST REPORT

Location _____

Rig up _____
Drilling and Remarks:

Rig ○

RECORD

Cased _____ in., _____ ft.
Sand _____
Gas _____
Oil _____
Total Depth _____

PRODUCTION

1st 24 hrs. Nat. _____
1st 24 hrs. after shot _____
Gas _____ Cu. Ft.
Dry Hole _____
Abandoned _____

Date

FEB 24 1937 19 S. J. LEWIS Scout