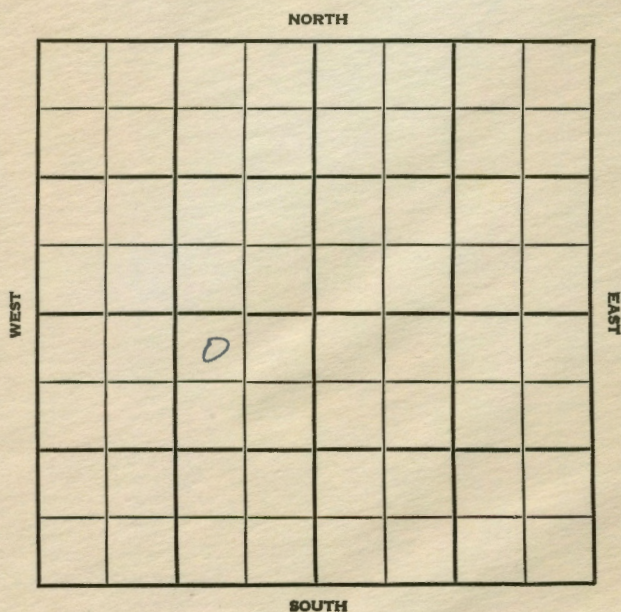


Section 1 Township 35E Range 2EWell No. #4 DeanCompany L. C. Smitherman

SEC.	TWP.	R.
1	35	2E

WELL NO. #4 Dean FARMCOMPANY L.C. SmithermanCONTRACTOR SoROBee
Hilltop


_____ FT. FROM N. LINE

_____ FT. FROM S. LINE

_____ FT. FROM E. LINE

_____ FT. FROM W. LINE

NW NE SW

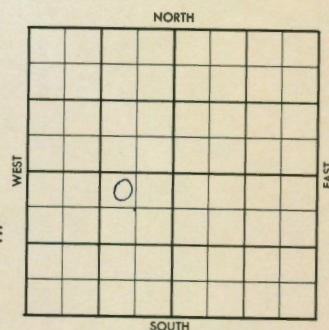

1956

ELEVATION

REPORT

8-29

Comm. 8-22-56
8" @ 173 w/200
Drlg. 2227'

County Sumner Elev. 1204 DF.
 Sec. 1 Twp. 35S Rge. 2E
 Company L. C. Smitherman
 FarmName Dean No. 4

TOPS	DEPTH	LOG	DATUM	Loc. in Sec.
Anh.				NW NE SW
Tp. <u>Stall</u>	<u>2380</u>			
H. <u>Gay</u>	<u>2806</u>			
Tr.				
Dg.				
BL.				
L.				
K.C.	<u>3005</u>			Geol.
BKG. <u>OSW</u>	<u>3207</u>			Contr.
Ce. <u>Bartl</u>	<u>3494</u>			<u>SoRoBee</u>
C.				Pool
M.	<u>3528</u>			<u>Hilltop</u>
K.				
Mz.				
Me.				
V.				
S.				
S.				
A.				
R.				
PC.				
G.				
TD.	<u>3530</u>			

Date Comm. 8-22-568" 173 w/200; D 2227 SEP 5 56 pipe setSEP 12 '56 5 1/2 @ 3520. pipe set.SEP 19 '56 SEP 26 '56 CO 3520 24/

3510-16 Frac P. 25 Bopa
+ Trace wt

County Sumner Elev. 1204 DF.
 Sec. 1 Twp. 35S Rge. 2E
 Company L. C. Smitherman
 FarmName Dean No. 4

TOPS	DEPTH	LOG	DATUM	Loc. in Sec.
Anh.				NW NE SW
Tp.				
H.				
Tr.				
Dg.				
BL.				
L.				
K.C.				Geol.
BKG.				Contr.
Ce.				<u>SokoBee</u>
C.				Pool
M.				<u>Hilltop</u>
K.				
Mz.				
Me.				
V.				
S.				
S.				
A.				
R.				
PC.				
G.				
TD.				

Date Comm. 8-22-56

8" 173 w/200; D 2227

2201 2 932

.G.R.