


Section 1 Township 35 Range 2 E

Well No. # 2 Horton

Company L. C. Smitherman

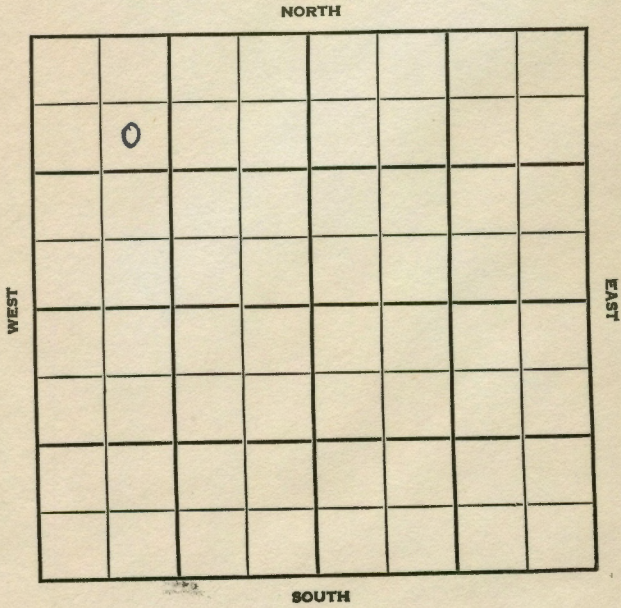

SEC.	TWP.	R.
1	35	2 E

WELL NO. # 2 Horton FARM

COMPANY L. C. Smitherman

CONTRACTOR Co. tools

Hilltop Pool


990 Ft. from N. Line

\_\_\_\_\_ Ft. from S. Line

\_\_\_\_\_ Ft. from E. Line

990 Ft. from W. Line

SE NW NW

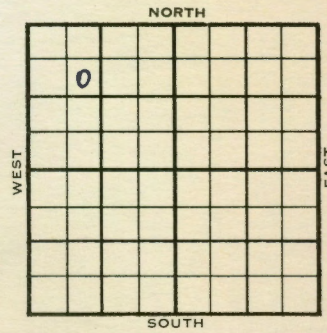

1954	ELEVATION	REPORT
	1210'	

12/29 Drlg. 1440'

1955  
3/2 Spud 12-25-54 Oil well TD 3497

8" @ 100 Stal. 2450 Layton 2813  
KC 3003 Oswego 3206 Bart 3487

DST 3485-97 open 1 hr rec 75' oil  
115' HO & GCM 760# TD 3497

7" @ 3487 CO to 3497 frac. S/25  
BFPH 50% wtr. S/3 BOPH

Comp. 25 BOPD

**COMPLETED**

County **Sumner** State **Kansas**  
 Sec. **1** (Blk. **35** (Sur. **2E**) Map No.  
 Operator **L. C. Smitherman**  
 Well No. **2** Farm **Horton**  
 Elev. \_\_\_\_\_ Location **SE NW NW**

o					

990 Ft. From **N** Line **NW**  
 990 Ft. From **W** Line **Quarter**  
 1st. Report **DEC 29 1954**  
 Completion \_\_\_\_\_  
 Remarks **Co. tools**  
 Spudding Date \_\_\_\_\_

Drig. Data **Hilltop Pool**  
**drig. 1440**

FABEN GILSTRAP

County **Sumner** State **Kansas**  
 Sec. **1** (Blk. **35** (Sur. **2E**) Map No.  
 Operator **L. C. Smitherman**  
 Well No. **2** Farm **Horton**  
 Elev. **1210** Location **SE NW NW**

o					

990Ft. From **N** Line **NW**  
 990Ft. From **W** Line **Quarter**  
 1st. Report \_\_\_\_\_  
 Completion **MAR 2 1955**  
 Remarks **Hilltop Pool**  
**Co. tools**  
 Spudding Date **12-25-54**

Drig. Data **Oil well TD 3497**  
**8" @ 100 Stal. 2450 Layton 2813**  
**KC 3003 Oswego 3206 Bart. 3487**  
**DST 3485-97 open 1 hr. Rec. 75' oil**  
**115' ho & gcm 760# TD 3497 7" @ 3487**  
**CO to 3497 frac S/ 25 bfph 50% wtr.**  
**S/ 3 boph Comp. 25 bopd**

FABEN GILSTRAP