


Section 1 Township 35 Range 2 E

Well No. # 3 Horton

Company L. C. Smitherman

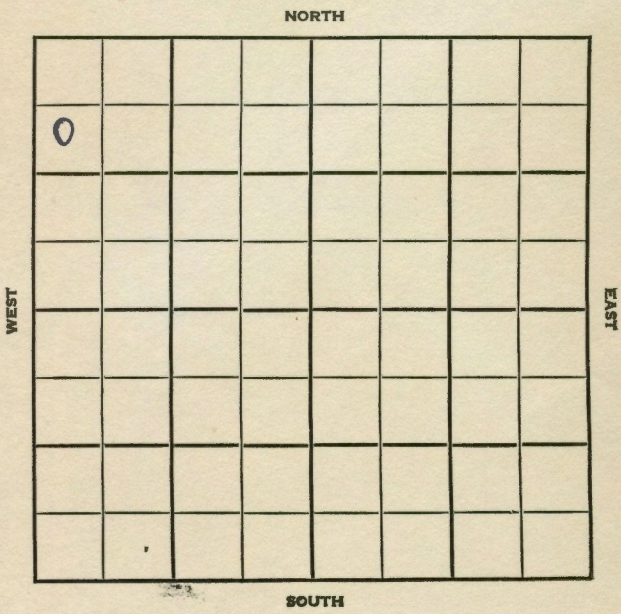

SEC. <u>1</u>	TWP. <u>35</u>	R. <u>2E</u>
---------------	----------------	--------------

WELL NO. 3 Horton FARM

COMPANY L. C. Smitherman


CONTRACTOR Co. Tools Hilltop Pool

990 Ft. from N. Line

_____ Ft. from S. Line

_____ Ft. from E. Line

330 Ft. from W. Line

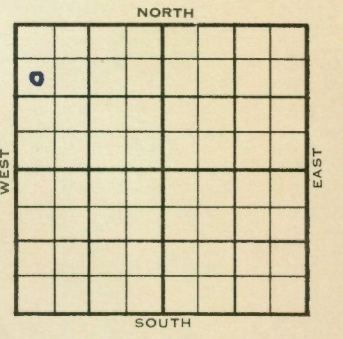

SW NW NW

1955	ELEVATION <u>1215'</u>	REPORT
------	------------------------	--------

1/12 Spud 1-6-55
8" @ 100'
Drlg. 1500'

1/26 Spud 1-6-55 Oil well TD 3503
8" @ 100 **Bart 3486**
DST 3486-3503 open 1 hr rec 180' oil
840# TD 3503 5" @ 3486 CO to 3503
S/5 to 6 BOPH Comp. 25 BOPD

COMPLETED

County Sumner State Kansas
 Sec. 1 (Bk. 35 (Sur. 2E (Twp. 35) Rge.) Map No.
 Operator L. C. Smitherman
 Well No. 3 Farm Horton
 Elev. 1215 Location SW NW NW

0					

990 Ft. From N Line NW
 330 Ft. From W Line Quarter
 Ist. Report
 Completion JAN 26 1955
 Remarks Hilltop Pool
Co. tools
 Spudding Date 1-6-55

Drlg. Data Oil well TD 3503
8" @ 100 Bart. 3486 DST 3486-3503
open 1 hr. Rec. 180' oil 840#
TD 3503 5" @ 3486 CO to 3503
S/ 5 to 6 boph Comp. 25 bopd

FABEN GILSTRAP

County Sumner State Kansas
 Sec. 1 (Bk. 35 (Sur. 2E (Twp. 35) Rge.) Map No.
 Operator L. C. Smitherman
 Well No. 3 Farm Horton
 Elev. Location SW NW NW

0					

990 Ft. From N Line NW
 330 Ft. From W Line Quarter
 Ist. Report JAN 12 1955
 Completion
 Remarks
Co. tools
 Spudding Date 1-6-55

Drlg. Data Hilltop Pool
8" @ 100 drlg. 1500

FABEN GILSTRAP