


Summer

KANSAS

SECTION 1 TOWNSHIP 35 RANGE 2E

WELL NO. #3 Dean

COMPANY Frank Strait

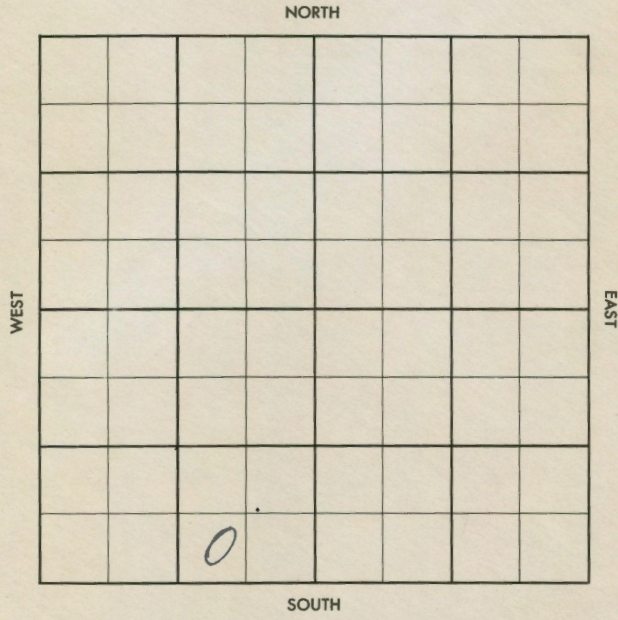

County Sumner Elev. _____
 Sec. 1 Twp. 35 Rge. 2E
 Company Frank Strait
 FarmName Dean No. 3

TOPS	DEPTH	LOG	DATUM	Loc. in Sec.
Anh.				SW SE SW
Tr.				
H.				
Tr.				
Dg.				
Bl.				
L.				Geol.
K.C.				Contr.
B.K.C.				<u>Smitherman Tools</u>
Ce.				Pool
C.				
M.				
K.				
Mr.				
Mo.				
V.				
S.				
S.				
A.				
R.				
Pe.				
G.				
TD				

FIRST REPORT
JAN 28 56

Date Comm. 12-26-56

~~29~~

County Sumner Elev. _____
 Sec. 1 Twp. 35 Rge. 2E
 Company Frank Strait
 FarmName Dean No. 3

TOPS	DEPTH	LOG	DATUM	Loc. in Sec.
Anh.				SW SE SW
Tr.				
H.				
Tr.				
Dg.				
Bl.				
L.				Geol.
K.C.				Contr.
B.K.C.				<u>Smitherman Tools</u>
Ce.				Pool
C.	<u>3307</u>			
M.	<u>Dartzen 3481</u>			
M.	<u>29 3505</u>			
K.	<u>3524</u>			
Mr.				
Mo.				
V.				
S.				
S.				
A.				
R.				
Pe.				
G.				
TD	<u>3530</u>			

ABANDONED

JAN 9 57

Date Comm. 12-26-56 JAN 2 57

2359 JAN 9 57 8578110

DEA