


Summer **KANSAS**Section 1 Township 35 Range 2EWell No. 1 HartonCompany L. C. Smitherman

NORTH

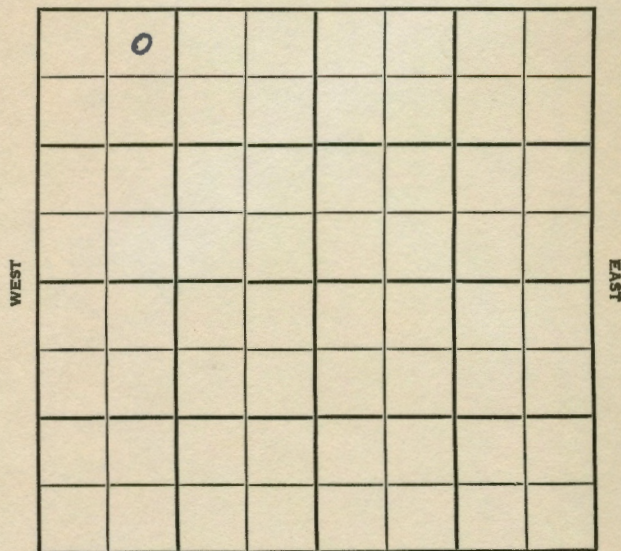


SOUTH

Summer **KANSAS**

SEC.	1	TWP.	35	R.	2E
WELL NO.	1 Harton				
COMPANY	L. C. Smitherman				
CONTRACTOR	FARM				

330 _____ Ft. from N. Line
 _____ Ft. from S. Line
 _____ Ft. from E. Line
 990 _____ Ft. from W. Line

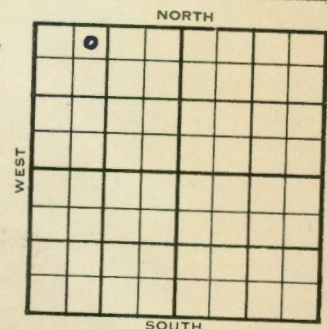NE NW NW
Sinc. DHM

1954	ELEVATION	REPORT
	1213'	

9/15 8" @ 118' w/125 sks
 12/1 Spud 10-13-54 Oil well TD 3531
 8" @ 118 **Stal. 2445 Layton 2803**
 DST 2803-08 open 1 hr rec 19' mud.
 36# **KC 2994 Big lime Osw 3201'**
Bart. 3478 Cong. 3521 Miss. 3525
 TD 3531 5" @ 3531 24/3505-09
 B/muddy wtr & oil CO to 3504
 32/3485-93 100 A P/40 BO 100 BWPD
 Comp. 15 BOPD 25 BW

COMPLETED

County	Summer		State	Kansas	
Sec.	1	(Blk. Twp.)	35	(Sur. Rge.)	2E
Operator	L. C. Smitherman				
Well No.	1	Farm	Harton		
Elev.	1213		Location	NE NW NW	
			330 Ft. From N Line NW		
			990 Ft. From W Line Quarter		
			1st. Report		
			Completion DEC 1 1954		
			Remarks		
			Co. tools		
			Spudding Date 10-13-54		

Drig. Data	Oil well	TD 3531
8" @ 118	Stal. 2445	Layton 2803
DST 2803-08	open 1 hr.	Rec. 19' mud
36#	KC 2994	Big lime Oswego 3201
Bart. 3478	Cong. 3521	Miss. 3525
TD 3531	5" @ 3531	24/ 3505-09
B/ muddy wtr. & oil	CO to 3504	
32/ 3485-93	100 A	P/ 40 bo 100 bwpd
Comp. 15 bopd	25 bw	

FABEN GILSTRAP

County	Summer		State	Kansas
Sec. 1	Blk. (Twp.) 35	Sur. (Rge.) 2E	Map No.	
Operator	L. C. Smithersan			
Well No. 1	Farm Harton			
Elev.	Location		NE NW NW	

0				

330	Ft. From	N	Line	NW
990	Ft. From	W	Line	Quarter

1st. Report SEP 15 1954

Completion _____

Remarks _____

Spudding Date _____

FIRST REPORT

Drlg. Data
8" @ 118 w/125 Sinc DHM

FABEN GILSTRAP