


DX 78-1 Summer

Section 1 Township 35 Range 2E **KANSAS**

Well No. 6 Horton

Company L. C. Smitherman

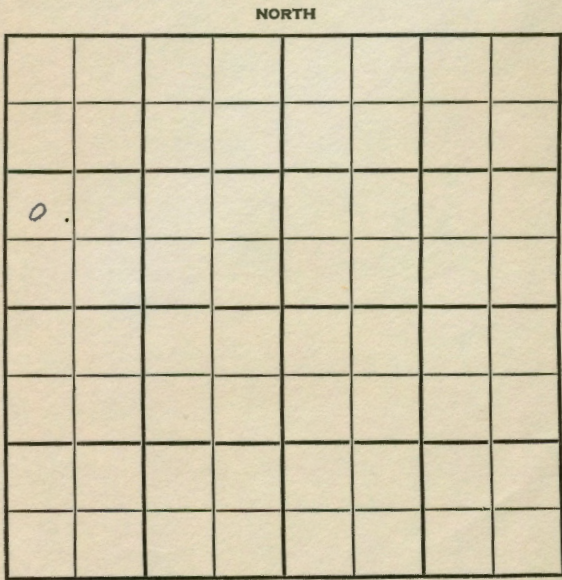

Summer **KANSAS**

SEC. <u>1</u>	TWP. <u>35</u>	R. <u>2 E</u>
---------------	----------------	---------------

WELL NO. # 6 Horton FAR

COMPANY L. C. Smitherman

CONTRACTOR Co. tools Hilltop Pool

_____ Ft. from N. Line

990 _____ Ft. from S. Line

_____ Ft. from E. Line

330 _____ Ft. from W. Line

NW SW NW

	ELEVATION	REPORT
1955	1217' KB	
4/27	MIR	
5/25	8-5/8" @ 100	Lost hole
	Skid 12' south	
	Spud 4-29-55	8-5/8" @ 108 w/125
	5 1/2" @ 3532	CO 24/3492-98
	F/8 BOPH 12 hr.	
	Comp. F/25 BOPD	
	Tops: Stal. 2363' , Lay 2808' ,	
	Kans. City 3007' , Osw 3211' ,	
	Bart 3491'	
	TD 3532' Comp.	
	COMPLETED	

