

Sumner

KANSAS

DX 78-1

Section 4 Township 35 Range 2E

Well No. #1 Chandler

Company Royal Oil

NORTH

				0			

WEST

EAST

SOUTH


SEC.	TWP.	R.
4	35	2E

WELL NO. #1 Chandler FARM

COMPANY Royal Oil

CONTRACTOR Tex-O-kan

\_\_\_\_\_ Ft. from N. Line  
 990 \_\_\_\_\_ Ft. from S. Line  
 \_\_\_\_\_ Ft. from E. Line  
 330 \_\_\_\_\_ Ft. from W. Line  
 NW SW SE

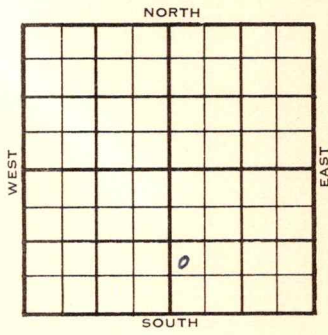

	ELEVATION	REPORT
--	-----------	--------

1954	1145'	
10/20	Spud 10-10-54 8" @ 74' Drlg. 2265'	
11/3	Spud 10-10-54 8" @ 74' Stal. 2307', Layton 2740', KC 2952', leve 3064', Oswego 3125', Bart 3375', Miss 3394' DST 2332-40', opn 1 hr., rec. 2' free oil, 15' ocm, 80' wtr, 700# TD 3455' D&A	

**ABANDONED**



