


Section 4 Township 35 Range 2E

Well No. 3 Coggins

Company A. D. Allsion

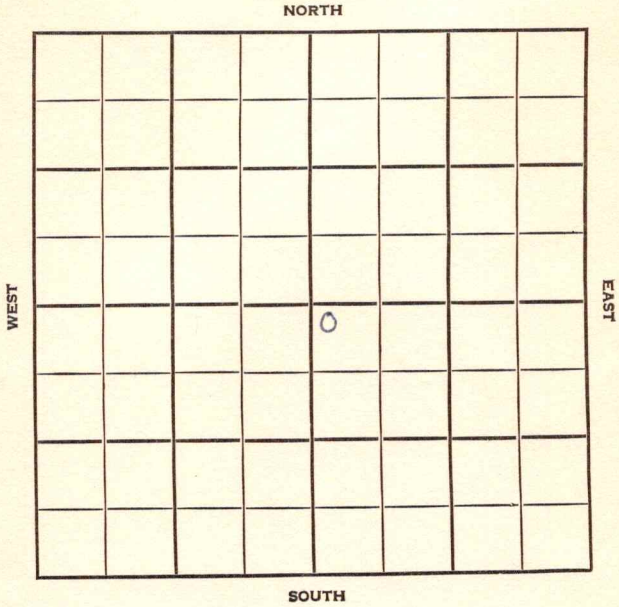

Sumner

KANSAS

SEC. 4	TWP. 35	R. 2E
--------	---------	-------

WELL NO. #1 Coggins FARM

COMPANY A. D. Allsion

CONTRACTOR Ca pitt

Dyal


\_\_\_\_\_ Ft. from N. Line

\_\_\_\_\_ Ft. from S. Line

\_\_\_\_\_ Ft. from E. Line

\_\_\_\_\_ Ft. from W. Line

NW NW SE

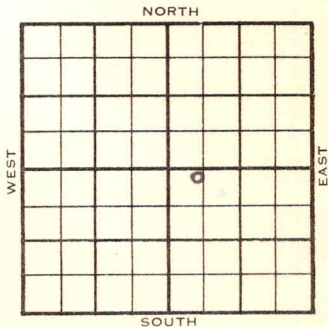

FIRST REPORT

	ELEVATION	REPORT
1955	1161	
7/13	MIR	
12-21	Comm. 7-12-55 8 5/8" @ 108/100 5" @ 3420 CO 20/ 2765-70 6 1/2 bw 30 min. 36/ 2330-39 wtr., frac 36/ 2319-28 P/ 10 bopd, 50% wtr. P/ 15 bopd 75% wtr. SP 2329 perf/ 2319-28 P/ 7 bo 25 BWPD DD 3461 Comp. 20 BOPD Stal. 2329 Layton 2746 KC 2949 Cleve 3065 M. 3398 TD 3425'	

COMPLETED

County Summer Elev. 1161  
 Sec. 4 Twp. 35 Rge. 2E  
 Company A. D. Allison  
 Farm Name Goggins No. 1

TOPS	DEPTH	LOG	DATUM	Loc. in Sec.
Anh.				NW NW SE
TP. <u>Stal</u>	<u>2329</u>		<u>1168</u>	
H. <u>Zayton</u>	<u>2746</u>		<u>1585</u>	
Tr.				
Dg.				
Bl.				
L.				
K.C.	<u>2949</u>		<u>1788</u>	Geol.
B.K.C. <u>Clene.</u>	<u>3065</u>		<u>1904</u>	Contr.
Ce.				
C.				
M.				
M.	<u>3398</u>		<u>2237</u>	Pool
K.				
Mz.				
Mq.				
V.				
S.				
S.				
A.				
R.				
Pe.				
G.				
TD.	<u>3425</u>			



Date Comm. 7-12-55 DEC 21 1955  
8 5/8" @ 108/100 TD 3425 5" @ 3420  
CO 20/ 2765-70 6 1/2 bw 30 min.  
36/ 2330-39 wtr. frac 36/ 2319-28  
P/ 10 bopd 50% wtr. P/ 15 bopd 75% wtr  
SP 2329 perf/ 2319-28 P/ 7 bo 25 bwpd  
DD 3461 Comp. 20 bopd

County Sumner Elev. \_\_\_\_\_  
 Sec. 4- Twp. 35 Rgs. 2E  
 Company A. D. Allsion  
 FarmName Coggins No. 1

TOPS	DEPTH	LOG	DATUM
Anh.			
Tp.			
H.			
Tr.			
Dg.			
Bl.			
L.			
K.C.			
B.K.C.			
Ce.			
C.			
M.			
M.			
K.			
Mz.			
Mq.			
V.			
S.			
S.			
A.			
R.			
Pe.			
G.			
T.D.			

Loc. in Sec. NW NW SE

Geol. \_\_\_\_\_

Contr. Capitt

Pool \_\_\_\_\_

Dyal

FIRST REPORT		
JUL 13 '55		

Date Comm. M I R

Co.  
Lse.  
No.  
Sec.  
T.  
R.