


DX 78-1 Sumner

KANSAS

Section 4 Township 35S Range 2E

Well No. #2 Wentworth

Company E. E. Riggs

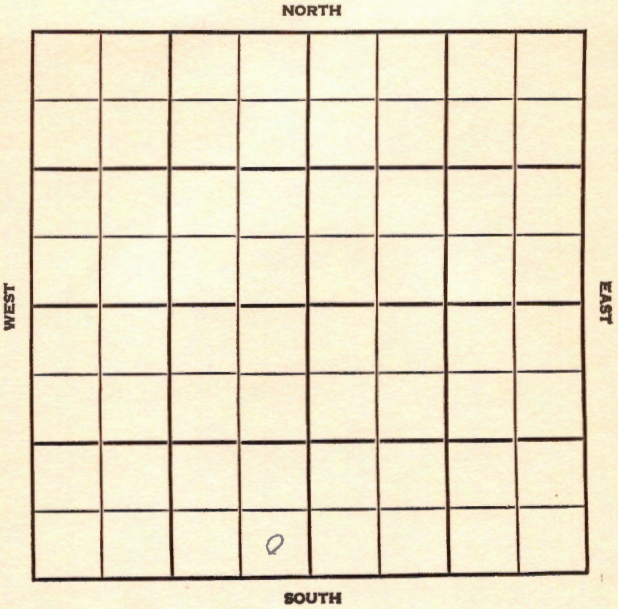

SEC.

4

TWP.

35

R.

2E

WELL NO.

#2 Wentworth

FARM

COMPANY

E.H. Riggs

CONTRACTOR

Cappitt

Padgett


____ FT. FROM N. LINE

____ FT. FROM S. LINE

____ FT. FROM E. LINE

____ FT. FROM W. LINE

SE SE SW

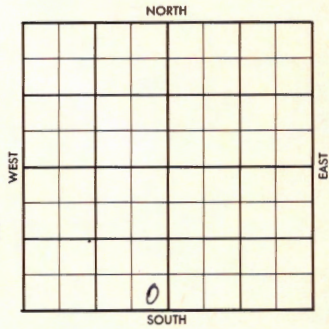

ELEVATION

REPORT

1956

8-22

Comm. 8-16-56
8" @ 97 w/85
Drlg. 2380
Stal. 2348'

County Sumner Elev. _____
 Sec. 4 Twp. 35S Rge. 2E
 Company E. H. Riggs
 Farm Name Wentworth No. 2

TOPS	DEPTH	LOG	DATUM	Loc. in Sec.
Anh. <u>Stal.</u>	<u>2348</u>			<u>SE SE SW</u>
Tr.				
H.				
Tr.				
Dg.				
Bl.				
L.				
K.C.				Geol. _____
B.K.C.				Contr. _____
Ce.				<u>Cappitt</u>
C.				
M.				Pool _____
M.				<u>Padgett</u>
K.				
Mz.				
Mq.				
V.				
S.				
S.				
A.				
R.				
Pe.				
G.				
T.D.				

FIRST REPORT

AUG 22 '56

0

Date Comm. 8-16-56
8th 97 W/85; D 2380

AUG 5 1956

D.R.

County Sunmer Elev. 1161
 Sec. 4 Twp. 35S Rge. 2E
 Company E. H. Riggs
 Farm Name Wentworth No. 2

TOPS	DEPTH	LOG	DATUM	Loc. in Sec.
Anb. <u>Stal.</u>	<u>2348</u>			<u>SE SE SW</u>
Tr.				
Dg.				
Bl.	<u>2293</u>			
L. <u>Stall</u>	<u>2333</u>			
K.C. <u>L. Stall</u>	<u>2391</u>			Geol.
B.K.C. <u>Lay</u>	<u>2775</u>			Contr.
Ce. <u>KC</u>	<u>2973</u>			<u>Cappitt</u>
C. <u>cleve.</u>	<u>3022-3100</u>			Pool
M.	<u>3421</u>			<u>Padgett</u>
M.				
K.				
Mz.				
Me.				
V.				
S.				
S.				
A.				
R.				
Pe.				
G.				
TD.	<u>3458</u>			

Date Comm. 8-16-56
 8th 97 W/85; D 2380

AUG 29 '58

DST 3435-53 2 hrs G/L hrs
net 70' GCM BHP 370/20
DST 3435-58 2 hrs G/L 2 hrs
245' GCM FP 33-70 no BHP
5 1/2 @ 3440 58 CO 3458 Frac
BLD SEP 12 '56 SEP 19 '56 P. 25 Bord
+ TV. wtr.